

WATER WELL RECORD

Form WWC-5


Division of Water Resources App. No.

| | | | | |
|--|---------------------------------|----------------------|------------------------|---|
| 1 LOCATION OF WATER WELL: County: COFFEY | Fraction NW ¼ NW ¼ NW ¼ NW ¼ | Section Number 34 | Township No. T 20 S | Range Number R 17 <input checked="" type="checkbox"/> E <input type="checkbox"/> W |
|--|---------------------------------|----------------------|------------------------|---|

Street/Rural Address of Well Location; if unknown, distance & direction from nearest town or intersection: If at owner's address, check here .
1695 Xeric Lane, Westphalia, Kansas (Dry well)

Global Positioning System (GPS) information:
Latitude: 38.273446 (in decimal degrees)
Longitude: -95.525541 (in decimal degrees)
Elevation: _____
Datum: WGS 84, NAD 83, NAD 27
Collection Method:
 GPS unit (Make/Model: _____)
 Digital Map/Photo, Topographic Map, Land Survey
Est. Accuracy: <3 m, 3-5 m, 5-15 m, >15 m

2 WATER WELL OWNER: CLEMENT BURKHOLDER
RR#, Street Address, Box #: 28885 NW COLORADO RD
City, State, ZIP Code : GARNETT, KS 66032

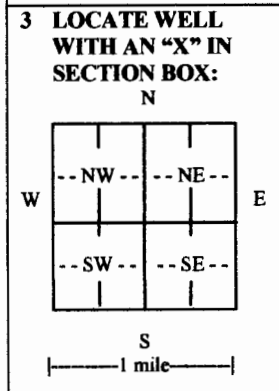

4 DEPTH OF COMPLETED WELL 140 ft.
Depth(s) Groundwater Encountered (1) NONE ft. (2) _____ ft. (3) _____ ft.
WELL'S STATIC WATER LEVEL NONE ft. below land surface measured on mo/day/yr. _____
Pump test data: Well water was _____ ft. after _____ hours pumping. _____ gpm
EST. YIELD 0 gpm. Well water was _____ ft. after _____ hours pumping. _____ gpm
Bore Hole Diameter _____ in. to _____ ft., and _____ in. to _____ ft.
WELL WATER TO BE USED AS: Public water supply Geothermal Injection well
 Domestic Feedlot Oil field water supply Dewatering Other (Specify below)
 Irrigation Industrial Domestic-lawn & garden Monitoring well _____
Was a chemical/bacteriological sample submitted to Department? Yes No
If yes, mo/day/yr sample was submitted. _____
Water well disinfected? Yes No

5 TYPE OF CASING USED: Steel PVC Other _____
CASING JOINTS: Glued Clamped Welded Threaded
Casing diameter _____ in. to _____ ft., Diameter _____ in. to _____ ft., Diameter _____ in. to _____ ft.
Casing height above land surface _____ in., Weight _____ lbs./ft., Wall thickness or gauge No. _____
TYPE OF SCREEN OR PERFORATION MATERIAL:
 Steel Stainless Steel PVC Other (Specify) _____
 Brass Galvanized Steel None used (open hole)
SCREEN OR PERFORATION OPENINGS ARE:
 Continuous slot Mill slot Gauze wrapped Torch cut Drilled holes None (open hole)
 Louvered shutter Key punched Wire wrapped Saw cut Other (specify) _____
SCREEN-PERFORATED INTERVALS: From _____ ft. to _____ ft., From _____ ft. to _____ ft.
From _____ ft. to _____ ft., From _____ ft. to _____ ft.
GRAVEL PACK INTERVALS: From _____ ft. to _____ ft., From _____ ft. to _____ ft.
From _____ ft. to _____ ft., From _____ ft. to _____ ft.

6 GROUT MATERIAL: Neat cement Cement grout Bentonite Other _____
Grout Intervals: From 140 ft. to 0 ft., From _____ ft. to _____ ft., From _____ ft. to _____ ft.
What is the nearest source of possible contamination:
 Septic tank Lateral lines Pit privy Livestock pens Insecticide storage Other (specify below)
 Sewer lines Cesspool Sewage lagoon Fuel storage Abandoned water well
 Watertight sewer lines Seepage pit Feedyard Fertilizer storage Oil well/gas well _____
Direction from well _____ Distance from well _____

| FROM | TO | LITHOLOGIC LOG | FROM | TO | LITHO. LOG (cont.) or PLUGGING INTERVALS |
|------|-----|----------------|------|----|--|
| 0 | 17 | SOIL/CLAY | | | |
| 17 | 28 | SHALE | | | |
| 28 | 38 | SANDSTONE | | | |
| 38 | 50 | SANDY SHALE | 140 | 0 | HIGH SOLIDS BENTONITE GROUT |
| 50 | 53 | SANDSTONE | | | |
| 53 | 103 | SANDY SHALE | | | |
| 103 | 140 | SHALE | | | DRILLED FOR WATER, FOUND NONE PLUGGED |

7 CONTRACTOR'S OR LANDOWNER'S CERTIFICATION: This water well was constructed, reconstructed, or plugged under my jurisdiction and was completed on (mo/day/year) 08/04/2015... and this record is true to the best of my knowledge and belief.
Kansas Water Well Contractor's License No. 561... This Water Well Record was completed on (mo/day/year) 08/04/2015...
under the business name of EVANS ENERGY DEVELOPMENT, INC. by (signature) [Signature]

INSTRUCTIONS: Use typewriter or ball point pen. PLEASE PRESS FIRMLY and PRINT clearly. Please fill in blanks and check the correct answers. Send one copy to Kansas Department of Health and Environment, Bureau of Water, Geology Section, 1000 SW Jackson St., Suite 420, Topeka, Kansas 66612-1367. Telephone 785-296-5524. Send one copy to WATER WELL OWNER and retain one for your records. Include fee of \$5.00 for each constructed well. Visit us at <http://www.kdheks.gov/waterwell/index.html>