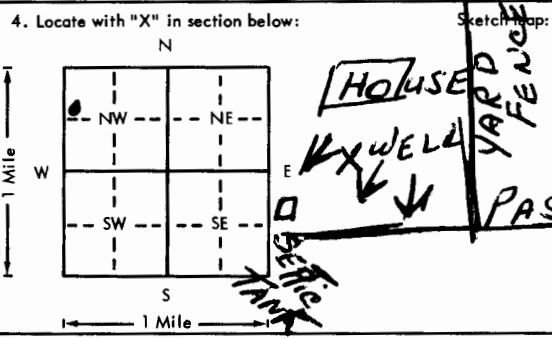


USE TYPEWRITER OR BALL POINT PEN-PRESS FIRMLY, PRINT CLEARLY.

WATER WELL RECORD
KSA 82a-1201-1215

Kansas Department of Health and Environment-Division of Environment
(Water well Contractors)
Topeka, Kansas 66620

1. Location of well: County <u>Coffey</u>		Fraction <u>1/4 NW/4</u>	Section number <u>8</u>	Township number <u>T 20 S R 17 E/W</u>	Range number
2. Distance and direction from nearest town or city: Street address of well location if in city:			3. Owner of well: <u>EDDIE KUNKLE</u> R.R. or street: <u>R.R. WAVERLY, KANSAS</u> City, state, zip code: <u>66</u>		
4. Locate with "X" in section below: Sketch map: 			6. Bore hole dia. <u>8 3/4 in.</u> Completion date _____ Well depth <u>207</u> ft.		
5. Type and color of material			7. <input checked="" type="checkbox"/> Cable tool <input type="checkbox"/> Rotary <input type="checkbox"/> Driven <input type="checkbox"/> Dug <input type="checkbox"/> Hollow rod <input type="checkbox"/> Jetted <input type="checkbox"/> Bored <input type="checkbox"/> Reverse rotary		
			8. Use: <input checked="" type="checkbox"/> Domestic <input type="checkbox"/> Public supply <input type="checkbox"/> Industry <input type="checkbox"/> Irrigation <input type="checkbox"/> Air conditioning <input checked="" type="checkbox"/> Stock <input type="checkbox"/> Lawn <input type="checkbox"/> Oil field water <input type="checkbox"/> Other		
			9. Casing: Material <u>STEEL</u> Weight: Above or below Threaded <input type="checkbox"/> Welded <input checked="" type="checkbox"/> Surface <u>OIL FIELD</u> RMP <input type="checkbox"/> PVC <input checked="" type="checkbox"/> Weight <u>TYPE</u> lbs./ft. Dia. <u>0</u> in. to <u>36</u> ft. depth Wall Thickness: inches or Dia. <u>0</u> in. to <u>0</u> ft. depth Lags No. _____		
			10. Screen Manufacturer: <u>Swank</u> <u>160 & CRES LINE</u> Type <u>PVC</u> Dia. <u>1/4 HOLES</u> Slot/gauze _____ Length _____ Set between <u>173</u> ft. and <u>209</u> ft. ft. and _____ ft. Gravel pack? <u>NONE</u> range of material _____		
			11. Static water level: _____ mo./day/yr. <u>160</u> ft. below land surface Date <u>7/5/79</u>		
			12. Pumping level below land surfaces: _____ ft. after _____ hrs. pumping _____ g.p.m. _____ ft. after _____ hrs. pumping _____ g.p.m. Estimated maximum yield _____ g.p.m.		
			13. Water sample submitted: _____ mo./day/yr. Yes <input checked="" type="checkbox"/> No <input type="checkbox"/> Date _____		
			14. Well head completion: <input type="checkbox"/> Pitless adapter _____ Inches above grade		
			15. Well grouted? <u>YES</u> With: <input type="checkbox"/> Neat cement <input type="checkbox"/> Bentonite <input checked="" type="checkbox"/> Concrete Depth: From <u>0</u> ft. to <u>36</u> ft.		
			16. Nearest source of possible contamination: <u>SEPTIC</u> ft. <u>30</u> Direction <u>SW</u> Type <u>TANK</u> Well disinfected upon completion? <input checked="" type="checkbox"/> Yes <input type="checkbox"/> No		
			17. Pump: <u>Not installed</u> Manufacturer's name <u>RED JACKET</u> Model number <u>MAB</u> HP <u>3/4</u> Volts <u>230</u> Length of drop pipe <u>200</u> ft. capacity <u>10</u> g.p.m. Type: <input checked="" type="checkbox"/> Submersible <input type="checkbox"/> Turbine <input type="checkbox"/> Jet <input type="checkbox"/> Reciprocating <input type="checkbox"/> Centrifugal <input type="checkbox"/> Other		
			20. Water well contractor's certification: This well was drilled under my jurisdiction and this report is true to the best of my knowledge and belief. <u>SWANK WATER WELL DRILLING</u> Business Address: <u>RR. PRINCETON, K.S.</u> Signed: <u>George W. Swank</u> Date _____ Authorized representative		
Topography: <input type="checkbox"/> Hill <input checked="" type="checkbox"/> Slope <input type="checkbox"/> Upland <input type="checkbox"/> Valley			LAND SLOPE AWAY FROM WELL TO SOUTH.		

Forward the white, blue and pink copies to the Department of Health and Environment

Form WWC-5