

Anderson Co File

December 23, 1976

Water sample collected by George Swank, driller,
from well he drilled in NW SW sec 5, T 20'S R 19'E,
Anderson Co Ks.

Well is 80ft deep, had white water sand at 55 to
80ft.

Art Day ran water analysis

3,000 mg/l Cl^- —
6,900 mg/l dissolved solids
9,700 Conductivity

Water not suitable for domestic use.

13-17-36


Gowing
Dec 30, 1976

Oscar King

Rt 1 - Box 180

Pomona Hs
66076

T-15-16-S DOUGLAS CO. APPANOOSE DOUGLAS CO. R-17-18-E

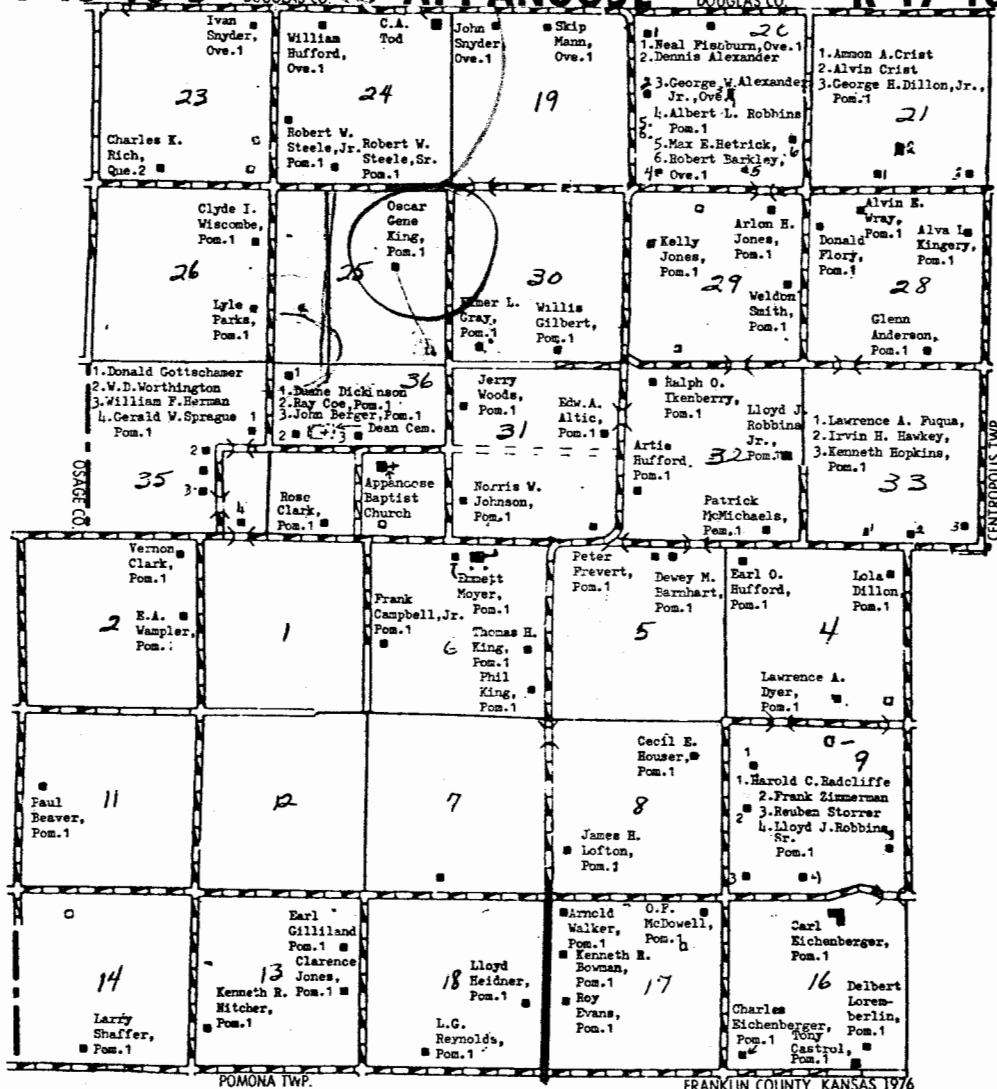

POMONA TWP.

FRANKLIN COUNTY, KANSAS 1976

CENTROPOLIS TWP.