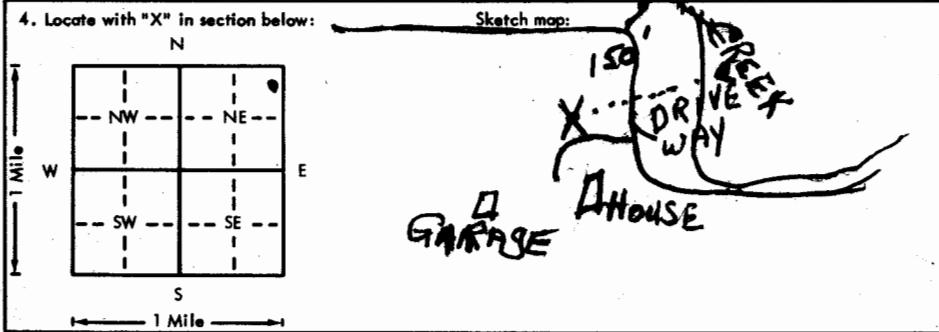


USE TYPEWRITER OR BALL POINT PEN—PRESS FIRMLY, PRINT CLEARLY.

WATER WELL RECORD  
KSA 82a-1201-1215

Kansas Department of Health and Environment—Division of Environment  
(Water well Contractors)  
Topeka, Kansas 66620

1. Location of well:		County <b>ANDERSON</b>	Fraction <b>1/4 NE 1/4 SW 1/4</b>	Section number <b>5</b>	Township number <b>T 20 S R 19</b>	Range number <b>19</b>
2. Distance and direction from nearest town or city: <b>1 1/2 miles southwest Richmond Kansas</b>		3. Owner of well: <b>Frank C. Yeager</b>		R.R. or street: <b>RR 2</b>		
Street address of well location if in city: <b>66032</b>		City, state, zip code: <b>Barnett Kansas 66032</b>			6. Bore hole dia. <b>6 1/2</b> in. Completion date <b>12/29/76</b> Well depth <b>80</b> ft.	
4. Locate with "X" in section below: Sketch map: 		7. <input checked="" type="checkbox"/> Cable tool <input type="checkbox"/> Rotary <input type="checkbox"/> Driven <input type="checkbox"/> Dug <input type="checkbox"/> Hollow rod <input type="checkbox"/> Jetted <input type="checkbox"/> Bored <input type="checkbox"/> Reverse rotary		8. Use: <input checked="" type="checkbox"/> Domestic <input type="checkbox"/> Public supply <input type="checkbox"/> Industry <input type="checkbox"/> Irrigation <input type="checkbox"/> Air conditioning <input type="checkbox"/> Stock <input type="checkbox"/> Lawn <input type="checkbox"/> Oil field water <input type="checkbox"/> Other		
5. Type and color of material		From	To	9. Casing: Material <b>NONE</b> Height: Above or below Threaded <input type="checkbox"/> Welded <input type="checkbox"/> Surface <input type="checkbox"/> in. RMP: <input type="checkbox"/> PVC <input type="checkbox"/> Weight <input type="checkbox"/> lbs./ft. Dia. <input type="checkbox"/> in. to <input type="checkbox"/> ft. depth Wall Thickness: inches or Dia. <input type="checkbox"/> in. to <input type="checkbox"/> ft. depth gage No. <input type="checkbox"/>		
<b>Soil + joint clay</b>		<b>90</b>	<b>9</b>	10. Screen: Manufacturer's name <b>NONE</b> Type <input type="checkbox"/> Dia. <input type="checkbox"/> Slot/gauze <input type="checkbox"/> Length <input type="checkbox"/> Set between <input type="checkbox"/> ft. and <input type="checkbox"/> ft. <input type="checkbox"/> ft. and <input type="checkbox"/> ft. Gravel pack? <input type="checkbox"/> Size range of material <input type="checkbox"/>		
<b>Blue lime</b>		<b>189</b>	<b>27</b>	11. Static water level: <b>DRY HOLE</b> no./day/yr. ft. below land surface Date <b>12/24/76</b>		
<b>Trace of Gray shale</b>				12. Pumping level below land surfaces: <input type="checkbox"/> ft. after <input type="checkbox"/> hrs. pumping <input type="checkbox"/> g.p.m. <input type="checkbox"/> ft. after <input type="checkbox"/> hrs. pumping <input type="checkbox"/> g.p.m. Estimated maximum yield <b>DRY HOLE</b> g.p.m.		
<b>White lime</b>		<b>2327</b>	<b>50</b>	13. Water sample submitted: <input checked="" type="checkbox"/> Yes <input type="checkbox"/> No Date <b>12/16/76</b> mg./day/yr.		
<b>Gray shale</b>		<b>550</b>	<b>55</b>	14. Well head completion: <b>NONE</b> <input type="checkbox"/> Pitless adapter <input type="checkbox"/> inches above grade		
<b>White sand</b>		<b>2555</b>	<b>80</b>	15. Well grouted? <b>PLUGGED</b> With: <input type="checkbox"/> Neat cement <input type="checkbox"/> Bentonite <input type="checkbox"/> Concrete Depth: From <input type="checkbox"/> ft. to <input type="checkbox"/> ft.		
<b>Sample water tested 12/16/76</b>				16. Nearest source of possible contamination: ft. <input type="checkbox"/> Direction <input type="checkbox"/> Type <input type="checkbox"/> Well disinfected upon completion? <input type="checkbox"/> Yes <input type="checkbox"/> No		
<b>as. 3000 Parts Per M Salt</b>				17. Pump: <input type="checkbox"/> Not installed Manufacturer's name <b>NONE</b> Model number <input type="checkbox"/> HP <input type="checkbox"/> Volts Length of drop pipe <input type="checkbox"/> ft. capacity <input type="checkbox"/> g.p.m. Type: <input type="checkbox"/> Submersible <input type="checkbox"/> Turbine <input type="checkbox"/> Jet <input type="checkbox"/> Reciprocating <input type="checkbox"/> Centrifugal <input type="checkbox"/> Other		
<b>6900 mg/L Dissolved Solids</b>				18. Elevation: Topography: <input type="checkbox"/> Hill <input checked="" type="checkbox"/> Slope <input type="checkbox"/> Upland <input type="checkbox"/> Valley		
(Use a second sheet if needed)				19. Remarks: <b>Hole Plugged with gravel packed with drill tools every 10' to 50' Cement with 2 sand 2 gravel 2 cement to 40'</b>		
				20. Water well contractor's certification: This well was drilled under my jurisdiction and this report is true to the best of my knowledge and belief. <b>SWANK WATER WELL DRILLING</b> Business name <b>P.R.I. PRINCE TOWNS</b> Address <b>1407 W. 1st St.</b> Signed <b>George Swank</b> Date <b>12/29/76</b> Authorized representative		

Forward the white, blue and pink copies to the Department of Health and Environment

Form WWC-3