


1 LOCATION OF WATER WELL: County: Anderson Fraction: SE 1/4 SE 1/4 NE 1/4 Section Number: 25 Township Number: T 20 S Range Number: R 19 EW

Distance and direction from nearest town or city street address of well if located within city?
IN TOWN

2 WATER WELL OWNER: Jean Meisman
RR#, St. Address, Box #: Meisman Conoco
City, State, ZIP Code: 3rd Maple; Garnett, Ks.
Board of Agriculture, Division of Water Resources
Application Number:

3 LOCATE WELL'S LOCATION WITH AN "X" IN SECTION BOX:

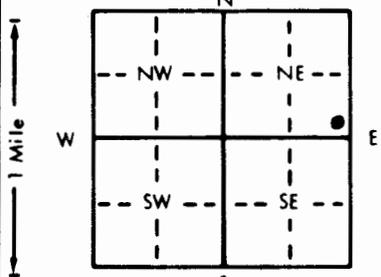

4 DEPTH OF COMPLETED WELL: 15' 6" ft. ELEVATION: _____ ft.
Depth(s) Groundwater Encountered: 1. 11' ft. 2. _____ ft. 3. _____ ft.
WELL'S STATIC WATER LEVEL: 5.05 ft. below land surface measured on mo/day/yr 11-10-94
Pump test data: Well water was _____ ft. after _____ hours pumping _____ gpm
Est. Yield _____ gpm: Well water was _____ ft. after _____ hours pumping _____ gpm
Bore Hole Diameter: 3.5" - 3.6" to _____ ft., and _____ in. to _____ ft.
WELL WATER TO BE USED AS:
1 Domestic 5 Public water supply 8 Air conditioning 11 Injection well
2 Irrigation 3 Feedlot 6 Oil field water supply 9 Dewatering 12 Other (Specify below)
3 Feedlot 7 Lawn and garden only 10 Monitoring well
Was a chemical/bacteriological sample submitted to Department? Yes _____ No X; If yes, mo/day/yr sample was submitted _____
Water Well Disinfected? Yes _____ No X

5 TYPE OF BLANK CASING USED:
1 Steel 2 PVC 3 RMP (SR) 4 ABS
5 Wrought iron 6 Asbestos-Cement 7 Fiberglass
8 Concrete tile 9 Other (specify below)
Blank casing diameter: 2.375 in. to 5' ft., Dia _____ in. to _____ ft., Dia _____ in. to _____ ft.
Casing height above land surface: Flush Mount in., weight _____ lbs./ft. Wall thickness or gauge No. SDR-13 Sch 40

TYPE OF SCREEN OR PERFORATION MATERIAL:
1 Steel 2 Brass 3 Stainless steel 4 Galvanized steel 5 Fiberglass 6 Concrete tile 7 RMP (SR) 8 ABS
10 Asbestos-cement 11 Other (specify) 12 None used (open hole)

SCREEN OR PERFORATION OPENINGS ARE:
1 Continuous slot 3 Mill slot 2 Louvered shutter 3 Key punched
4 Gauzed wrapped 5 Wire wrapped 6 Torch cut 7 Saw cut 8 None (open hole)
9 Drilled holes 10 Other (specify)

SCREEN-PERFORATED INTERVALS: From 15' ft. to 5' ft., From _____ ft. to _____ ft.
GRAVEL PACK INTERVALS: From 15' 6" ft. to 4' ft., From _____ ft. to _____ ft.

6 GROUT MATERIAL: 1 Neat cement 2 Cement grout 3 Bentonite 4 Other
Grout Intervals: From 4' ft. to 3' ft., From 3' ft. to 0' ft., From _____ ft. to _____ ft.
What is the nearest source of possible contamination:
1 Septic tank 2 Sewer lines 3 Watertight sewer lines 4 Lateral lines 5 Cess pool 6 Seepage pit 7 Pit privy 8 Sewage lagoon 9 Feedyard
10 Livestock pens 11 Fuel storage Fuel 12 Fertilizer storage 13 Insecticide storage 14 Abandoned water well 15 Oil well/Gas well 16 Other (specify below)
Direction from well? East How many 60-80'

FROM	TO	LITHOLOGIC LOG	FROM	TO	PLUGGING INTERVALS
0	3.00	DK Brn - Brn silty clay, firm, roots, hard, calcified			
3.0	11.25	Limestone, hard, fractured w/ob at 11', no odor			
11.25	15.50	DK Gray shale, dry, hard, no odor			

7 CONTRACTOR'S OR LANDOWNER'S CERTIFICATION: This water well was (1) constructed, (2) reconstructed, or (3) plugged under my jurisdiction and was completed on (mo/day/year) 10-28-94 and this record is true to the best of my knowledge and belief. Kansas Water Well Contractor's License No. 539 This Water Well Record was completed on (mo/day/yr) 11-28-94 under the business name of JB Environmental Drilling by (signature) James Bieker