


1 LOCATION OF WATER WELL: County: Marion Fraction: SW 1/4 NW 1/4 NW 1/4 Section Number: 3 Township Number: T 20 S Range Number: R 2 E

Distance and direction from nearest town or city street address of well if located within city? 701 S. Main St., Hillsboro, KS

2 WATER WELL OWNER: Salem Hospital Board of Agriculture, Division of Water Resources
 RR#, St. Address, Box #: 701 Main St. Application Number: MW1
 City, State, ZIP Code: Hillsboro, KS

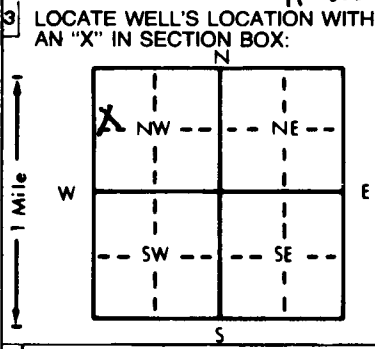

4 DEPTH OF COMPLETED WELL: 25 ft. ELEVATION: 1414.90
 Depth(s) Groundwater Encountered 1. 1403.67 ft. 2. — ft. 3. — ft.
 WELL'S STATIC WATER LEVEL 11.23 ft. below land surface measured on mo/day/yr 5/19/99
 Pump test data: Well water was — ft. after — hours pumping — gpm
 Est. Yield — gpm: Well water was — ft. after — hours pumping — gpm
 Bore Hole Diameter: 8 in. to 30 25 ft., and — in. to — ft.
 WELL WATER TO BE USED AS:
 1 Domestic 3 Feedlot 6 Oil field water supply 9 Dewatering 12 Other (Specify below)
 2 Irrigation 4 Industrial 7 Lawn and garden only Monitoring well
 5 Public water supply 8 Air conditioning 11 Injection well
 Was a chemical/bacteriological sample submitted to Department? Yes No ; If yes, mo/day/yr sample was submitted
 Water Well Disinfected? Yes No

5 TYPE OF CASING USED:
 1 Steel 3 RMP (SR) 5 Wrought iron 8 Concrete tile CASING JOINTS: Glued Clamped
 2 PVC 4 ABS 6 Asbestos-Cement 9 Other (specify below) Welded
 Blank casing diameter 5 in. to 5 ft., Dia. — in. to — ft., Dia. — in. to — ft.
 Casing height above land surface Flush in., weight — lbs./ft. Wall thickness or gauge No. —
 TYPE OF SCREEN OR PERFORATION MATERIAL:
 1 Steel 3 Stainless steel 5 Fiberglass 8 RMP (SR) 10 Asbestos-cement
 2 Brass 4 Galvanized steel 6 Concrete tile 9 ABS 11 Other (specify)
 SCREEN OR PERFORATION OPENINGS ARE:
 Continuous slot 3 Mill slot 5 Gauzed wrapped 8 Saw cut 11 None (open hole)
 Louvered shutter 4 Key punched 6 Wire wrapped 9 Drilled holes
 7 Torch cut 10 Other (specify)
 SCREEN-PERFORATED INTERVALS: From 30 25 ft. to 20 5 ft., From — ft. to — ft.
 GRAVEL PACK INTERVALS: From 30 25 ft. to 14 3 ft., From — ft. to — ft.

6 GROUT MATERIAL: 1 Neat cement 2 Cement grout Bentonite 4 Other
 Grout Intervals: From 14 3 ft. to 1 ft., From — ft. to — ft.
 What is the nearest source of possible contamination:
 1 Septic tank 4 Lateral lines 7 Pit privy Fuel storage 14 Abandoned water well
 2 Sewer lines 5 Cess pool 8 Sewage lagoon 12 Fertilizer storage 15 Oil well/Gas well
 3 Watertight sewer lines 6 Seepage pit 9 Feedyard 13 Insecticide storage 16 Other (specify below)
 Direction from well? in tank pit How many feet? 0

FROM	TO	LITHOLOGIC LOG	FROM	TO	PLUGGING INTERVALS
0	25	Brown silty clay			

7 CONTRACTOR'S OR LANDOWNER'S CERTIFICATION: This water well was constructed, reconstructed, or plugged under my jurisdiction and was completed on (mo/day/year) 5-17-99 and this record is true to the best of my knowledge and belief. Kansas Water Well Contractor's License No. 6034 This Water Well Record was completed on (mo/day/yr) 5-25-99 under the business name of Shirley Env. Testing LLC by (signature) [Signature]

INSTRUCTIONS: Use typewriter or ball point pen. PLEASE PRESS FIRMLY and PRINT clearly. Please fill in blanks, underline or circle the correct answers. Send top three copies to Kansas Department of Health and Environment, Bureau of Water, Topeka, Kansas 66620-0001. Telephone: 913-296-5545. Send one to WATER WELL OWNER and retain one for your records.

OFFICE USE ONLY T R EW SEC 1/4 1/4 1/4 1/4