


1 LOCATION OF WATER WELL: County: Marion Fraction: SW 1/4 NW 1/4 NW 1/4 Section Number: 3 Township Number: T 20 S Range Number: R 2 E

Distance and direction from nearest town or city street address of well if located within city? 701 S. Main St., Hillsboro, KS

2 WATER WELL OWNER: Salem Hosp. & RR# Board of Agriculture, Division of Water Resources
 RR#, St. Address, Box #: 701 S. Main St. Application Number: NW3
 City, State, ZIP Code: Hillsboro

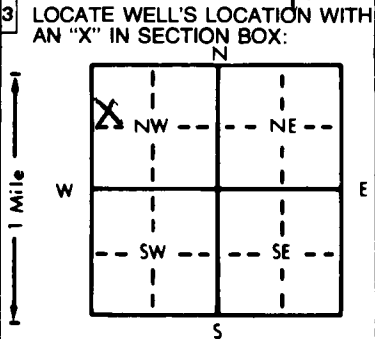

4 DEPTH OF COMPLETED WELL: 25 ft. ELEVATION: 1414.93
 Depth(s) Groundwater Encountered 1. 1404.11 ft. 2. — ft. 3. — ft.
 WELL'S STATIC WATER LEVEL 10.32 ft. below land surface measured on mo/day/yr 5/19/99
 Pump test data: Well water was — ft. after — hours pumping — gpm
 Est. Yield — gpm; Well water was — ft. after — hours pumping — gpm
 Bore Hole Diameter: 8 in. to 25 ft., and — in. to — ft.
 WELL WATER TO BE USED AS:
 5 Public water supply 8 Air conditioning 11 Injection well
 1 Domestic 3 Feedlot 6 Oil field water supply 9 Dewatering 12 Other (Specify below)
 2 Irrigation 4 Industrial 7 Lawn and garden only 10 Monitoring well
 Was a chemical/bacteriological sample submitted to Department? Yes — No X; If yes, mo/day/yr sample was submitted
 Water Well Disinfected? Yes — No X

5 TYPE OF BLANK CASING USED:
 1 Steel 3 RMP (SR) 5 Wrought iron 8 Concrete tile CASING JOINTS: Glued — Clamped —
2 PVC 4 ABS 6 Asbestos-Cement 9 Other (specify below) Welded —
 7 Fiberglass Threaded X
 Blank casing diameter 2 in. to 5 ft., Dia — in. to — ft., Dia — in. to — ft.
 Casing height above land surface Flush in., weight — lbs./ft. Wall thickness or gauge No. —
 TYPE OF SCREEN OR PERFORATION MATERIAL:
 1 Steel 3 Stainless steel 5 Fiberglass 8 RMP (SR) 10 Asbestos-cement
 2 Brass 4 Galvanized steel 6 Concrete tile 9 ABS 11 Other (specify) —
 12 None used (open hole)
 SCREEN OR PERFORATION OPENINGS ARE:
1 Continuous slot 3 Mill slot 5 Gauzed wrapped 8 Saw cut 11 None (open hole)
 2 Louvered shutter 4 Key punched 6 Wire wrapped 9 Drilled holes
 7 Torch cut 10 Other (specify) —
 SCREEN-PERFORATED INTERVALS: From 25 ft. to 5 ft., From — ft. to — ft.
 GRAVEL PACK INTERVALS: From 25 ft. to X 3 ft., From — ft. to — ft.

6 GROUT MATERIAL: X 3 1 Neat cement 2 Cement grout 3 3 Bentonite 4 Other —
 Grout Intervals: From X 3 ft. to — ft., From — ft. to — ft.
 What is the nearest source of possible contamination:
 1 Septic tank 4 Lateral lines 7 Pit privy 11 10 Livestock pens 14 Abandoned water well
 2 Sewer lines 5 Cess pool 8 Sewage lagoon 12 Fertilizer storage 15 Oil well/Gas well
 3 Watertight sewer lines 6 Seepage pit 9 Feedyard 13 Insecticide storage 16 Other (specify below)
 Direction from well? South east How many feet? 40

FROM	TO	LITHOLOGIC LOG	FROM	TO	PLUGGING INTERVALS
<u>0</u>	<u>25</u>	<u>Brown & gray silty clay</u>			

7 CONTRACTOR'S OR LANDOWNER'S CERTIFICATION: This water well was (1) constructed, (2) reconstructed, or (3) plugged under my jurisdiction and was completed on (mo/day/year) 5-18-99 and this record is true to the best of my knowledge and belief. Kansas Water Well Contractor's License No. 634 This Water Well Record was completed on (mo/day/yr) 5-25-99 under the business name of Shelby Env. Testing LLC by (signature) [Signature]

OFFICE USE ONLY
T
R
EW
SEC.