

Well No 1


WATER WELL RECORD Form WWC-5 KSA 82a-1212

1 LOCATION OF WATER WELL: County: Maury Fraction: SW 1/4 NW 1/4 NE 1/4 Section Number: 28 Township Number: T 20 S Range Number: R 2 E

Distance and direction from nearest town or city street address of well if located within city?
4 1/2 W Hillsboro

2 WATER WELL OWNER: Michael Kleiber
 RR#, St. Address, Box #: 910 S 1st Board of Agriculture, Division of Water Resources
 City, State, ZIP Code: Hillsboro, KS 67063 Application Number:

3 LOCATE WELL'S LOCATION WITH AN "X" IN SECTION BOX:

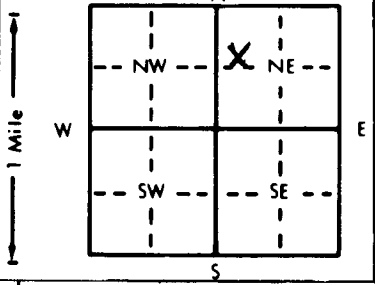

4 DEPTH OF COMPLETED WELL: 80 ft. ELEVATION:
 Depth(s) Groundwater Encountered: 24 65 ft. 2. 6-26-00 ft. 3. 80 ft.
 WELL'S STATIC WATER LEVEL: 24 65 ft. below land surface measured on mo/day/yr
 Pump test data: Well water was 20 gpm Well water was 7 1/2 ft. after 20 hours pumping 80 gpm
 Est. Yield 20 gpm Well water was 7 1/2 ft. after 20 hours pumping 80 gpm
 Bore Hole Diameter: 20 in. to 20 ft. and 7 1/2 in. to 80 ft.
 WELL WATER TO BE USED AS:
 1 Domestic 3 Feedlot 6 Oil field water supply 9 Dewatering 12 Other (Specify below)
 2 Irrigation 4 Industrial 7 Lawn and garden only 10 Monitoring well
 Was a chemical/bacteriological sample submitted to Department? Yes X No X; If yes, mo/day/yr sample was submitted
 Water Well Disinfected? Yes X No

5 TYPE OF BLANK CASING USED:
 1 Steel 3 RMP (SR) 5 Wrought iron 8 Concrete tile CASING JOINTS: Glued X Clamped
 2 PVC 4 ABS 6 Asbestos-Cement 9 Other (specify below) Welded
 7 Fiberglass Threaded

Blank casing diameter: 5 in. to 50 ft. Dia. 1 1/2 in. to 160 lbs./ft. Wall thickness or gauge No. 2 1/4

TYPE OF SCREEN OR PERFORATION MATERIAL:
 1 Steel 3 Stainless steel 5 Fiberglass 8 RMP (SR) 10 Asbestos-cement
 2 Brass 4 Galvanized steel 6 Concrete tile 9 ABS 11 Other (specify)

SCREEN OR PERFORATION OPENINGS ARE:
 1 Continuous slot 3 Mill slot 5 Gauzed wrapped 8 Saw cut 11 None (open hole)
 2 Louvered shutter 4 Key punched 6 Wire wrapped 9 Drilled holes
 7 Torch cut 10 Other (specify)

SCREEN-PERFORATED INTERVALS: From 50 ft. to 80 ft. From 80 ft. to 80 ft.
 GRAVEL PACK INTERVALS: From 20 ft. to 80 ft. From 80 ft. to 80 ft.

6 GROUT MATERIAL: 1 Neat cement 2 Cement grout 3 Bentonite 4 Other
 Grout Intervals: From 0 ft. to 20 ft. From 20 ft. to 80 ft. From 80 ft. to 80 ft.

What is the nearest source of possible contamination:
 1 Septic tank 4 Lateral lines 7 Pit privy 10 Livestock pens 14 Abandoned water well
 2 Sewer lines 5 Cess pool 8 Sewage lagoon 11 Fuel storage 15 Oil well/Gas well
 3 Watertight sewer lines 6 Seepage pit 9 Feedyard 12 Fertilizer storage 16 Other (specify below)
 13 Insecticide storage

Direction from well? Will be 100-200' How many feet?

FROM	TO	LITHOLOGIC LOG	FROM	TO	PLUGGING INTERVALS
0	22	Yellow Clay			
22	65	Blue + Gray Shale			
65	66	Water			
66	80	Gray Hard Shale			

7 CONTRACTOR'S OR LANDOWNER'S CERTIFICATION: This water well was (1) constructed, (2) reconstructed, or (3) plugged under my jurisdiction and was completed on (mo/day/year) 6-29-00 and this record is true to the best of my knowledge and belief. Kansas Water Well Contractor's License No. 190 This Water Well Record was completed on (mo/day/yr) 7-9-00 under the business name of Backhus Drilling by (signature) Taylor Backhus

INSTRUCTIONS: Use typewriter or ball point pen. PLEASE PRESS FIRMLY and PRINT clearly. Please fill in blanks, underline or circle the correct answers. Send top three copies to Kansas Department of Health and Environment, Bureau of Water, Topeka, Kansas 66620-0001. Telephone: 913-296-5545. Send one to WATER WELL OWNER and retain one for your records.