

CORRECTION TO WATER WELL RECORD (WWC-5)

The following correction(s) was made to the attached WWC-5 log, in order to file the item or to rectify lacking or incorrect information.

Fraction (1/4 1/4 1/4) Section-Township-Range changed:

listed as No legal description given

changed to SW NW NW, 3-205-2E

Other changes: Initial statements: _____

Changed to: _____

Comments: _____

verification method: Well address on form, Hillsboro city map,
and Hillsboro 1:24,000 topo. map. initials: DRD date: 4/24/2001


submitted by: Kansas Geological Survey, Data Resources Library, 1930 Constant Ave., Lawrence, KS 66047-3726
to: Kansas Dept of Health & Environment Bureau of Water Industrial Programs, Bldg 283, Forbes Field, KS 66620

1 LOCATION OF WATER WELL:	Fraction	Section Number	Township Number	Range Number
County: <u>Marion</u>	<u>1/4</u> <u>1/4</u> <u>1/4</u>		T <u>S</u> R	EW

Distance and direction from nearest town or city street address of well if located within city?
610 S Main Hillsboro

2 WATER WELL OWNER: Parkview Mennonite Church
 RR#, St. Address, Box # : 610 S Main
 City, State, ZIP Code : Hillsboro, KS, 67063
 Board of Agriculture, Division of Water Resources
 Application Number:

3 LOCATE WELL'S LOCATION WITH AN "X" IN SECTION BOX:

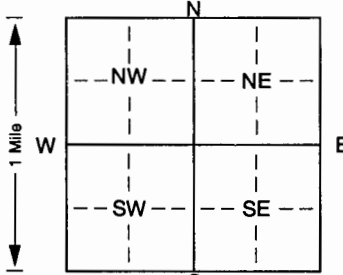

4 DEPTH OF COMPLETED WELL: 63 ft. ELEVATION:

Depth(s) Groundwater Encountered 1. 32 ft. 2. 57 ft. 3. ft.

WELL'S STATIC WATER LEVEL: 27 ft. below land surface measured on mo/day/yr

Pump test data: Well water was ft. after hours pumping gpm

Est. Yield 20-30 gpm: Well water was ft. after hours pumping gpm

Bore Hole Diameter: 2 1/2 in. to 20 ft., and 7 in. to 63 ft.

WELL WATER TO BE USED AS:

5 Public water supply	8 Air conditioning	11 Injection well
1 Domestic	3 Feedlot	6 Oil field water supply
2 Irrigation	4 Industrial	7 Domestic (lawn & garden)
		10 Monitoring well
		9 Dewatering
		12 Other (Specify below)

Was a chemical/bacteriological sample submitted to Department? Yes. No. X; If yes, mo/day/yr sample was submitted
 Water Well Disinfected? Yes X No

5 TYPE OF BLANK CASING USED:

1 Steel	3 RMP (SR)	5 Wrought iron	8 Concrete tile	CASING JOINTS: Glued <u>X</u> Clamped.
2 PVC	4 ABS	6 Asbestos-Cement	9 Other (specify below)	Welded
		7 Fiberglass		Threaded.

Blank casing diameter: 5 in. to 3.5 ft., Dia in. to ft., Dia in. to ft.

Casing height above land surface: 12 in., weight CLASS 160 lbs./ft. Wall thickness or gauge No. 214

TYPE OF SCREEN OR PERFORATION MATERIAL:

1 Steel	3 Stainless steel	5 Fiberglass	7 PVC	10 Asbestos-cement
2 Brass	4 Galvanized steel	6 Concrete tile	8 RMP (SR)	11 Other (specify)
			9 ABS	12 None used (open hole)

SCREEN OR PERFORATION OPENINGS ARE:

1 Continuous slot	3 Mill slot	5 Gauzed wrapped	8 Saw cut	11 None (open hole)
2 Louvered shutter	4 Key punched	6 Wire wrapped	9 Drilled holes	
		7 Torch cut	10 Other (specify)	ft.

SCREEN-PERFORATED INTERVALS: From 35 ft. to 63 ft., From ft. to ft.

GRAVEL PACK INTERVALS: From 20 ft. to 63 ft., From ft. to ft.

6 GROUT MATERIAL: 1 Neat cement 2 Cement grout 3 Bentonite 4 Other

Grout Intervals: From 0 ft. to 20 ft., From ft. to ft., From ft. to ft.

What is the nearest source of possible contamination:

1 Septic tank	4 Lateral lines	7 Pit privy	10 Livestock pens	14 Abandoned water well
2 Sewer lines	5 Cess pool	8 Sewage lagoon	11 Fuel storage	15 Oil well/Gas well
3 Watertight sewer lines	6 Seepage pit	9 Feedyard	12 Fertilizer storage	16 Other (specify below)
			13 Insecticide storage	

Direction from well? W How many feet? 30

FROM	TO	LITHOLOGIC LOG	FROM	TO	PLUGGING INTERVALS
<u>0</u>	<u>32</u>	<u>Yellow Clay + mixed Shale</u>			
<u>32</u>	<u>32</u>	<u>Blue Shale</u>			
<u>32</u>	<u>39</u>	<u>Some Water</u>			
<u>39</u>	<u>57</u>	<u>Blue Shale</u>			
<u>57</u>	<u>58</u>	<u>Water</u>			
<u>58</u>	<u>63</u>	<u>Blue + Gray Shale</u>			

7 CONTRACTOR'S OR LANDOWNER'S CERTIFICATION: This water well was (1) constructed, (2) reconstructed, or (3) plugged under my jurisdiction and was completed on (mo/day/year) 11-22-00 and this record is true to the best of my knowledge and belief. Kansas Water Well Contractor's Licence No. 187 This Water Well Record was completed on (mo/day/yr) 11-22-00 under the business name of Backus Drilling by (signature) Paul Backus