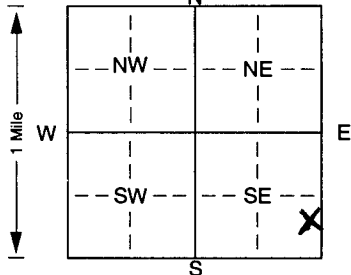


1 LOCATION OF WATER WELL: Fraction Ne 1/4 Se 1/4 Se 1/4 Section Number 7 Township Number T 20 S Range Number R 2 E  

Distance and direction from nearest town or city street address of well if located within city?  
2 S 2 W Hillsboro

2 WATER WELL OWNER: Gerald Jost  
 RR#, St. Address, Box #: 1707 Goldenrod Board of Agriculture, Division of Water Resources  
 City, State, ZIP Code: Hillsboro KS, 67063 Application Number:

3 LOCATE WELL'S LOCATION WITH AN "X" IN SECTION BOX:  
  
 4 DEPTH OF COMPLETED WELL: 95 ft. ELEVATION: 87  
 Depth(s) Groundwater Encountered: 1 ft. 2. 87 ft. 3. 87 ft.  
 WELL'S STATIC WATER LEVEL: 34 ft. below land surface measured on mo/day/yr  
 Pump test data: Well water was 2.0 gpm; Well water was 50 ft. after 7 hours pumping 95 gpm  
 Est. Yield: 2.0 gpm; Well water was 50 ft. after 7 hours pumping 95 gpm  
 Bore Hole Diameter: 9 in. to 50 ft., and 7 in. to 95 ft.  
 WELL WATER TO BE USED AS:  
 1 Domestic 3 Feedlot 6 Oil field water supply 9 Dewatering 12 Other (Specify below)  
 2 Irrigation 4 Industrial 7 Domestic (lawn & garden) 10 Monitoring well  
 Was a chemical/bacteriological sample submitted to Department? Yes. X No. X; If yes, mo/day/yrs sample was submitted  
 Water Well Disinfected? Yes X No

5 TYPE OF BLANK CASING USED:  
 1 Steel 3 RMP (SR) 5 Wrought iron 8 Concrete tile CASING JOINTS: Glued. X Clamped.  
 2 PVC 4 ABS 6 Asbestos-Cement 9 Other (specify below) Welded  
 7 Fiberglass Threaded  
 Blank casing diameter: 5 in. to 40 ft., Dia. 5 in. to 7.5 ft., Dia. in. to 7.5 ft.  
 Casing height above land surface: 12 in., weight Class 160 lbs./ft. Wall thickness or gauge No. 214  
 TYPE OF SCREEN OR PERFORATION MATERIAL:  
 1 Steel 3 Stainless steel 5 Fiberglass 7 PVC 10 Asbestos-cement  
 2 Brass 4 Galvanized steel 6 Concrete tile 8 RMP (SR) 11 Other (specify)  
 9 ABS 12 None used (open hole)  
 SCREEN OR PERFORATION OPENINGS ARE:  
 1 Continuous slot 3 Mill slot 5 Gauzed wrapped 8 Saw cut 11 None (open hole)  
 2 Louvered shutter 4 Key punched 6 Wire wrapped 9 Drilled holes  
 7 Torch cut 10 Other (specify) 7.5 ft.  
 SCREEN-PERFORATED INTERVALS: From 40 ft. to 50 ft., From 7.5 ft. to 9.5 ft.  
 From 50 ft. to 7.5 ft., From 9.5 ft. to 9.5 ft.  
 GRAVEL PACK INTERVALS: From 40 ft. to 50 ft., From 7.5 ft. to 9.5 ft.  
 From 50 ft. to 7.5 ft., From 9.5 ft. to 9.5 ft.

6 GROUT MATERIAL: 1 Neat cement 2 Cement grout 3 Bentonite 4 Other  
 Grout Intervals: From 0 ft. to 20 ft., From 20 ft. to 7.5 ft., From 7.5 ft. to 9.5 ft.  
 What is the nearest source of possible contamination:  
 1 Septic tank 4 Lateral lines 7 Pit privy 10 Livestock pens 14 Abandoned water well  
 2 Sewer lines 5 Cess pool 8 Sewage lagoon 11 Fuel storage 15 Oil well/Gas well  
 3 Watertight sewer lines 6 Seepage pit 9 Feedyard 12 Fertilizer storage 16 Other (specify below)  
 13 Insecticide storage  
 Direction from well? S W How many feet? 100+

FROM	TO	LITHOLOGIC LOG	FROM	TO	PLUGGING INTERVALS
0	40	Sandy Clay			
40	48	Sand			
48	87	Blue Shale			
87	90	Broken Shale + Water			
90	95	Gray Shale			

7 CONTRACTOR'S OR LANDOWNER'S CERTIFICATION: This water well was (1) constructed, (2) reconstructed, or (3) plugged under my jurisdiction and was completed on (mo/day/year) 12-6-01 and this record is true to the best of my knowledge and belief. Kansas Water Well Contractor's Licence No. 180 This Water Well Record was completed on (mo/day/yr) 12-26-01 under the business name of Backhoe Drilling by (signature) [Signature]