

CORRECTION(S) TO WATER WELL RECORD (WWC-5)

(to rectify lacking or incorrect information)

County: Marion

Location listed as:

Location changed to:

Section-Township-Range: 21-Liberty-2E

21-205-2E

Fraction ($\frac{1}{4}$ $\frac{1}{4}$ $\frac{1}{4}$): None Given

NE NE SW

Other changes: Initial statements: _____

Changed to: _____

Comments: _____


verification method: Legal description, county ownership map,
and mapping tool on KGS website.

initials: DRD date: 6/9/2008

submitted by: Kansas Geological Survey, Data Resources Library, 1930 Constant Ave., Lawrence, KS 66047-3726
to: Kansas Dept of Health & Environment, Bureau of Water, 1000 SW Jackson, Suite 420, Topeka, KS 66612-1367.

1 LOCATION OF WATER WELL: Fraction Section Number Township Number Range Number
 County: Maion $\frac{1}{4}$ $\frac{1}{4}$ $\frac{1}{4}$ 21-~~2~~ Liberty 2 E E/W
 Distance and direction from nearest town or city street address of well if located within city?

2 WATER WELL OWNER: **GORDON & DORIS DALKE**
 2071 INDIGO
 HILLSBORO, KS 67063-8300
 RR #, St. Address, Box #: Board of Agriculture, Division of Water Resources
 City, State, ZIP Code: Application Number:

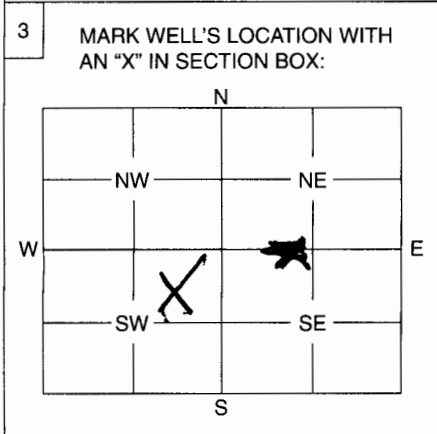

4 DEPTH OF WELL 19 ft.
 WELL'S STATIC WATER LEVEL 7 ft.
 WELL WAS USED AS:
 1 Domestic 5 Public Water Supply 9 Dewatering
 2 Irrigation 6 Oil Field Water Supply 10 Monitoring Well
 3 Feedlot 7 Domestic (Lawn & Garden) 11 Injection Well
 4 Industrial 8 Air Conditioning 12 Other
 Was a chemical / bacteriological sample submitted to Department? Yes No
 If yes, mo/day/yr sample was submitted
 Water Well Disinfected: Yes No

5 TYPE OF BLANK CASING USED:
 1 Steel 3 RMP (SR) 5 Wrought 7 Fiberglass 9 Other (Specify below)
 2 PVC 4 ABS 6 Asbestos-Cement 8 Concrete Tile ROCK
 Blank casing diameter in. Was casing pulled? Yes No If yes, how much
 Casing height above or below land surface 5' in.

6 GROUT PLUG MATERIAL: 1 Neat cement 2 Cement grout 3 Bentonite 4 Other
 Grout Plug Intervals: From 5 ft. to 4.5 ft., From ft. to ft., From to ft.
 What is the nearest source of possible contamination:
 1 Septic tank 6 Seepage pit 11 Fuel storage 16 Other (specify below)
 2 Sewer lines 7 Pit privy 12 Fertilizer storage NONE
 3 Watertight sewer lines 8 Sewage lagoon 13 Insecticide storage
 4 Lateral lines 9 Feedyard 14 Abandoned water well
 5 Cess pool 10 Livestock pens 15 Oil well/Gas well
 Direction from well? How many feet?

FROM	TO	PLUGGING MATERIALS
		<u>49 + oz CHLORINE</u>
<u>12'</u>	<u>5'</u>	<u>2 703 SAND + DIRT FILL</u>
<u>5'</u>	<u>4.5'</u>	<u>14 - 50# BAGS BENTONITE</u>
<u>4.5'</u>	<u>0'</u>	<u>DIRT + TOPSOIL</u>
<u>19'</u>	<u>12'</u>	<u>KNOCK IN TOP</u>

7 CONTRACTOR'S OR LANDOWNER'S CERTIFICATION: This water well was plugged under my jurisdiction and was completed on (mo/day/year) 17 MAY 08 and this record is true to the best of my knowledge and belief. Kansas Water Well Contractor's License No. This Water Well Record was completed on (mo/day/year)
 by (signature) DALKE Under the business name of DALKE CONSTRUCTION INC.

INSTRUCTIONS: Use typewriter or ball point pen. Please press firmly and print clearly. Please fill in blanks, underline or circle the correct answers. Send top three copies to Kansas Department of Health and Environment, Bureau of Water, Geology Section, 1000 SW Jackson St., Ste. 420, Topeka, Kansas 66612-1367. Telephone: 785/296-5522. Send one to Water Well Owner and retain one for your records.