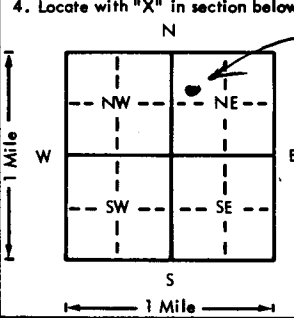


USE TYPEWRITER OR BALL POINT PEN PRESS FIRMLY PRINT CLEARLY.

WATER WELL RECORD
KSA 820-1201-1215

Kansas Department of Health and Environment-Division of Environment
(Water well Contractors)
Topeka, Kansas 66620

1. Location of well: County: WAGONER		Fraction: 1/4 NW 1/4 NE 1/4	Section number: 9	Township number: T 20	Range number: S R 2 E
2. Distance and direction from nearest town or city: Street address of well location if in city: 1/2 mile 50-1/4 West of Hillsboro, KS			3. Owner of well: PAUL PENNER R.R. or street: RR. City, state, zip code: HILLSBORO, KANSAS 67063		
4. Locate with "X" in section below: Sketch map: 			6. Bore hole dia. 18 in. Completion date 11-1 Well depth 68 ft. 76		
5. Type and color of material			7. <input type="checkbox"/> Cable tool <input type="checkbox"/> Rotary <input type="checkbox"/> Driven <input type="checkbox"/> Dug <input type="checkbox"/> Hollow rod <input type="checkbox"/> Jetted <input type="checkbox"/> Bored <input checked="" type="checkbox"/> Reverse rotary		
			8. Use: <input type="checkbox"/> Domestic <input type="checkbox"/> Public supply <input type="checkbox"/> Industry <input checked="" type="checkbox"/> Irrigation <input type="checkbox"/> Air conditioning <input type="checkbox"/> Stock <input type="checkbox"/> Lawn <input type="checkbox"/> Oil field water <input type="checkbox"/> Other		
			9. Casing: Material PVC Height: Above or below Threaded <input type="checkbox"/> Welded <input checked="" type="checkbox"/> Surface 2 1/2 in. RMP <input type="checkbox"/> PVC <input checked="" type="checkbox"/> Weight 4 lbs./ft. Dia. 4 in. to 68 ft. depth Wall Thickness: inches or Dia. <input type="checkbox"/> in. to <input type="checkbox"/> ft. depth gage No. 3/4"		
			10. Screen: Manufacturer's name CASTLE Type PVC Dia. 8" Slot/gauze 1/8 Length 20 Set between 48 ft. and 68 ft. ft. and <input type="checkbox"/> ft. Gravel pack? <input checked="" type="checkbox"/> Size range of material 1/4"		
			11. Static water level: <input type="checkbox"/> mo./day/yr. 28 ft. below land surface Date 11-5-76		
			12. Pumping level below land surfaces: 72 ft. after 10 hrs. pumping 450 g.p.m. ft. after <input type="checkbox"/> hrs. pumping <input type="checkbox"/> g.p.m. Estimated maximum yield 450 g.p.m.		
			13. Water sample submitted: <input type="checkbox"/> mo./day/yr. <input checked="" type="checkbox"/> Yes <input type="checkbox"/> No Date 11-15-76		
			14. Well head completion: NO <input type="checkbox"/> Pitless adapter <input type="checkbox"/> inches above grade		
			15. Well grouted? Yes - Ruddled clay With: <input type="checkbox"/> Neat cement <input type="checkbox"/> Bentonite <input type="checkbox"/> Concrete Depth: From 0 ft. to 15 ft.		
			16. Nearest source of possible contamination: ft. 1200 Direction West Type Fed Lot Well disinfected upon completion? <input type="checkbox"/> Yes <input checked="" type="checkbox"/> No		
			17. Pump: <input checked="" type="checkbox"/> Not installed Manufacturer's name <input type="checkbox"/> Model number <input type="checkbox"/> HP <input type="checkbox"/> Volts <input type="checkbox"/> Length of drop pipe <input type="checkbox"/> ft. capacity <input type="checkbox"/> g.p.m. Type: <input type="checkbox"/> Submersible <input type="checkbox"/> Turbine <input type="checkbox"/> Jet <input type="checkbox"/> Reciprocating <input type="checkbox"/> Centrifugal <input type="checkbox"/> Other		
18. Elevation:			19. Remarks:		
Topography: <input type="checkbox"/> Hill <input type="checkbox"/> Slope <input checked="" type="checkbox"/> Upland <input type="checkbox"/> Valley			Billed out		
			20. Water well contractor's certification: This well was drilled under my jurisdiction and this report is true to the best of my knowledge and belief. 138/A Peterson Irrigation Inc Business name License No. Address Box 150 Hillsboro, KS Signed William N. Peterson Date 12-6-76 Authorized representative		

Forward the white, blue and pink copies to the Department of Health and Environment

Form WWC-5