USE TYPEWRITER OR BALL POINT PEN-PRESS FIRMLY, PRINT CLEARLY.

WATER WELL RECORD
KSA 82a-1201-1215

Kansas Department of Health and Environment-Division of Environment
(Water well Contractors)
Topeka, Kansas 66620

1. Location of well:	County	Fraction	Section number	Township number	Range number
	Marion	SW 1/4 SW 1/4 SW 1/4	11	T 20 S	R 2 (E)/W

2. Distance and direction from nearest town or city:
Street address of well location if in city: 1 mile east, 2 south of Hillsboro

3. Owner of well: Jack Regier
R.R. or street: R.R. 2
City, state, zip code: Hillsboro, Kans. 67063

4. Locate with "X" in section below:

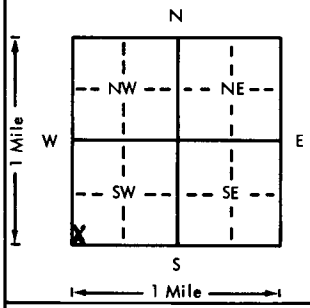

Sketch map:

6. Bore hole dio. 20 in. Completion date 5 - 12 - 77
Well depth 61 ft.

7. __ Cable tool __ Rotary __ Driven __ Dug
__ Hollow rod __ Jetted __ Bored X Reverse rotary

8. Use: __ Domestic __ Public supply __ Industry
X Irrigation __ Air conditioning __ Stock
__ Lawn __ Oil field water __ Other

9. Casing: Material cement asbestos
Threaded Sandy Welded
RMP PVC
Dia 16 in. to 61 ft. depth
Dia. in. to ft. depth
Height: Above or below Surface in.
Weight lbs./ft.
Wall Thickness: inches or gage No. 3/4"

10. Screen: Manufacturer's name Johnson Well Casing
Type ~~cement~~ asbestos transite Dia. 16"
Slot/gauze 5/32 Length 27'
Set between 23 ft. and 50 ft.
ft. and ft.
Gravel pack? Yes Size range of material to 3/16

11. Static water level: mo./day/yr.
8 ft. below land surface Date 5/12/77

12. Pumping level below land surfaces:
ft. after hrs. pumping g.p.m.
ft. after hrs. pumping g.p.m.
Estimated maximum yield 400+ g.p.m.

13. Water sample submitted: mo./day/yr.
__ Yes X No Date

14. Well head completion:
__ Pitless adapter Inches above grade

15. Well grouted? yes
With: X Neat cement __ Bentonite __ Concrete
Depth: From 0 ft. to 10 ft.

16. Nearest source of possible contamination:
ft. 100 Direction W Type Sewer
Well disinfected upon completion? __ Yes X No

17. Pump: X Not installed
Manufacturer's name
Model number HP Volts
Length of drop pipe ft. capacity g.p.m.
Type:
__ Submersible __ Turbine
__ Jet __ Reciprocating
__ Centrifugal __ Other

5. Type and color of material	From	To
Top soil	0	10
Sandy silt	10	23
Gravel 1/8 - 3/16	23	31
Blue shale	31	51
Gypsum rock	51	59

(Use a second sheet if needed)

18. Elevation:
Topography:
__ Hill
__ Slope
__ Upland
__ Valley

19. Remarks:

20. Water well contractor's certification:
This well was drilled under my jurisdiction and this report is true to the best of my knowledge and belief.
Business name Rader Drilling Co. License No. 194
Address Carlton, Kans. 67429
Signed Authorized representative Date 8-16-77

T 20 R 2 (E)/W Sec 11 1/4 SESWSW 1/4

Forward the white, blue and pink copies to the Department of Health and Environment

Form WWC-5

MI-1023