


1 LOCATION OF WATER WELL: Fraction Section Number Township Number Range Number
 County: Anderson NW 1/4 NW 1/4 NW 1/4 SW 30 20 20 EW

Distance and direction from nearest town or city street address of well if located within city?
EZ Start - 420 S. Maple ; Garrett, Ks.

2 WATER WELL OWNER: Shell Oil Products U.S.
 RR #, St. Address, Box #: 308 Wilcox #101
 City, State, ZIP Code: Castle Rock, Colo 80104
 Board of Agriculture, Division of Water Resources
 Application Number:

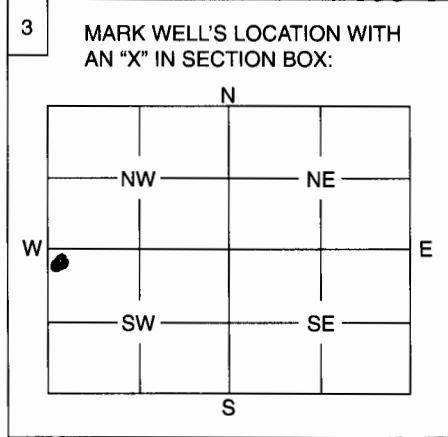

4 DEPTH OF WELL 10' ft.
 WELL'S STATIC WATER LEVEL 6.14 ft.
 WELL WAS USED AS:
 1 Domestic 5 Public Water Supply 9 Dewatering
 2 Irrigation 6 Oil Field Water Supply 10 Monitoring Well
 3 Feedlot 7 Domestic (Lawn & Garden) 11 Injection Well
 4 Industrial 8 Air Conditioning 12 Other
 Was a chemical / bacteriological sample submitted to Department? Yes No X.....
 If yes, mo/day/yr sample was submitted
 Water Well Disinfected: Yes No X.....

5 TYPE OF BLANK CASING USED:
 1 Steel 3 RMP (SR) 5 Wrought 7 Fiberglass 9 Other (Specify below)
2 PVC 4 ABS 6 Asbestos-Cement 8 Concrete Tile
 Blank casing diameter 2.0 in. Was casing pulled? Yes X No If yes, how much 10'
 Casing height above or below land surface Flush Mt. in.

6 GROUT PLUG MATERIAL: 1 Neat cement 2 Cement grout 3 Bentonite 4 Other Cement
 Grout Plug Intervals: From 10' ft. to 6" ft., From 6" ft. to 0' ft., From to ft.
 What is the nearest source of possible contamination:
 1 Septic tank 6 Seepage pit 11 Fuel storage 16 Other (specify below)
 2 Sewer lines 7 Pit privy 12 Fertilizer storage
 3 Watertight sewer lines 8 Sewage lagoon 13 Insecticide storage
 4 Lateral lines 9 Feedyard 14 Abandoned water well
 5 Cess pool 10 Livestock pens 15 Oil well/Gas well
 Direction from well? East How many feet? 20'

| FROM | TO | PLUGGING MATERIALS |
|------------|-----------|--------------------|
| <u>10'</u> | <u>6"</u> | <u>Bentonite</u> |
| <u>6"</u> | <u>0</u> | <u>Cement</u> |
| | | |
| | | |
| | | |
| | | |

Flush Mt. Manway was removed
2" PVC pipe was pulled out
Boreshole was drilled out to TO

7 CONTRACTOR'S OF LANDOWNER'S CERTIFICATION: This water well was plugged under my jurisdiction and was completed on (mo/day/year) 6-21-05 and this record is true to the best of my knowledge and belief. Kansas Water Well Contractor's License No. 732 This Water Well Record was completed on (mo/day/year) under the business name of QB Environmental Supply by (signature) James Bieker

INSTRUCTIONS: Use typewriter or ball point pen. Please press firmly and print clearly. Please fill in blanks, underline or circle the correct answers. Send top three copies to Kansas Department of Health and Environment, Bureau of Water, Geology Section, 1000 SW Jackson St., Ste. 420, Topeka, Kansas 66612-1367. Telephone: 785/296-5522. Send one to Water Well Owner and retain one for your records.