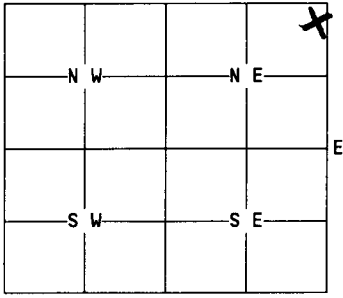


1	LOCATION OF WATER WELL:	Fraction	Section Number	Township Number	Range Number
	County: <u>Linn</u>	<u>NE<sup>1</sup>/<sub>4</sub> NE<sup>1</sup>/<sub>4</sub> NE<sup>1</sup>/<sub>4</sub></u>	<u>34</u>	<u>20S</u>	<u>22E</u>

Distance and direction from nearest town or city street address of well if located within city?  
16934 Gireau, Parker, KS. 66072

2	WATER WELL OWNER: <u>C.W. Ringey</u>	Board of Agriculture, Division of Water Resources
	RR#, St. Address, Box #: <u>16934 Gireau</u>	Application Number:
	City, State, ZIP Code: <u>Parker KS. 66072</u>	

3	MARK WELL'S LOCATION WITH AN "X" IN SECTION BOX:	4	DEPTH OF WELL..... <u>18</u> .....ft.
	N		WELL'S STATIC WATER LEVEL..... <u>9</u> .....ft.
			WELL WAS USED AS:
			<input checked="" type="radio"/> 1 Domestic <input type="radio"/> 2 Irrigation <input type="radio"/> 3 Feedlot <input type="radio"/> 4 Industrial <input type="radio"/> 5 Public Water Supply <input type="radio"/> 6 Oil Field Water Supply <input type="radio"/> 7 Lawn and Garden Only <input type="radio"/> 8 Air Conditioning <input type="radio"/> 9 Dewatering <input type="radio"/> 10 Monitoring Well <input type="radio"/> 11 Injection Well <input type="radio"/> 12 Other.....
			Was a chemical/bacteriological sample submitted to Department? Yes..... <u>No</u> .. If yes, mo/day/yr sample was submitted.....
			Water Well Disinfected: Yes <u>X</u> ..... No.....

5	TYPE OF BLANK CASING USED:
	1 Steel    3 RMP (SR)    5 Wrought    7 Fiberglass <u>6 Other (specify below)</u> 2 PVC    4 ABS    6 Asbestos-Cement    8 Concrete Tile <u>Rock Lined</u> .....
	Blank casing diameter... <u>60</u> ...in.    Was casing pulled? Yes..... No <u>X</u> ..... If yes, how much.....
	Casing height above or below land surface... <u>48</u> .....in.

6	GROUT PLUG MATERIAL: 1 Neat cement    2 Cement grout <u>3 Bentonite</u> 4 Other.....
	Grout Plug Intervals: From <u>5</u> ...ft. to <u>4</u> ...ft., From.....ft. to .....ft., From..... to.....ft.
	What is the nearest source of possible contamination:
	<input checked="" type="radio"/> 1 Septic tank    6 Seepage pit    11 Fuel storage    16 Other (specify below) <input checked="" type="radio"/> 2 Sewer lines    7 Pit privy    12 Fertilizer storage <input type="radio"/> 3 Watertight sewer lines    8 Sewage lagoon    13 Insecticide storage <input type="radio"/> 4 Lateral lines    9 Feedyard    14 Abandoned water well <input type="radio"/> 5 Cess Pool    10 Livestock pens    15 Oil well/Gas well
	Direction from well: <u>WNN</u> .....    How many feet? <u>100+</u> .....

FROM	TO	PLUGGING MATERIALS
<u>18</u>	<u>9</u>	<u>Sand</u>
<u>9</u>	<u>5</u>	<u>Compacted Clay</u>
<u>5</u>	<u>4</u>	<u>Bentonite</u>
<u>4</u>	<u>1</u>	<u>Compacted Clay</u>
<u>1</u>	<u>0</u>	<u>Top soil</u>

7	CONTRACTOR'S OR LANDOWNER'S CERTIFICATION: This water well was plugged under my jurisdiction and was completed on (mo/day/year) <u>7-1-07</u> ..... and this record is true to the best of my knowledge and belief. Kansas Water Well Contractor's License No. <u>561</u> ..... This Water Well Record was completed on (mo/day/year) <u>7-1-07</u> ..... under the business name of <u>EVANJ Energy Dev. Inc.</u> ..... by (signature) <u>Scott B. Lewis</u> .....
---	---

INSTRUCTIONS: Use typewriter or ball point pen. Please press firmly and print clearly. Please fill in blanks, underline or circle the correct answers. Send top three copies to Kansas Department of Health and Environment, Bureau of Water, Topeka, Kansas 66620-0001. Telephone: 785/296-3565. Send one to Water Well Owner and retain one for your records.