


LOCATION OF WATER WELL: County: Marion Fraction: 7/16 NE 1/4 NW 1/4 Section Number: 15 Township Number: T 20 S Range Number: R 3 E

Distance and direction from nearest town or city street address of well if located within city?
3 N 2 W Aylene

WATER WELL OWNER: Walter W. Nice
 RR#, St. Address, Box #: 705 Rosevelt
 City, State, ZIP Code: Marion, KS, 66861
 Board of Agriculture, Division of Water Resources
 Application Number:

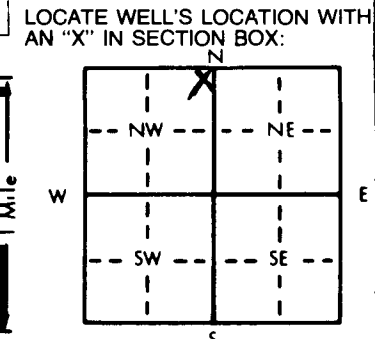

DEPTH OF COMPLETED WELL: 59.0 ft. ELEVATION: ft.
 Depth(s) Groundwater Encountered 1. ft. 2. ft. 3. ft.
 WELL'S STATIC WATER LEVEL: 13 ft. below land surface measured on mo/day/yr 4-8-94
 Pump test data: Well water was ft. after hours pumping gpm
 Est. Yield: 25 gpm; Well water was ft. after hours pumping gpm
 Bore Hole Diameter: 8 1/2 in. to 20 ft., and 6 1/2 in. to 59 ft.
 WELL WATER TO BE USED AS:
 1 Domestic 1 3 Feedlot 6 Oil field water supply 9 Dewatering 12 Other (Specify below)
 2 Irrigation 4 Industrial 7 Lawn and garden only 10 Monitoring well
 Was a chemical/bacteriological sample submitted to Department? Yes..... No X; If yes, mo/day/yr sample was submitted
 Water Well Disinfected? Yes X No

TYPE OF BLANK CASING USED:
 1 Steel 3 RMP (SR) 5 Wrought iron 8 Concrete tile CASING JOINTS: Glued X Clamped
 2 PVC 4 ABS 6 Asbestos-Cement 9 Other (specify below) Welded
 3 Fiberglass Threaded
 Blank casing diameter: 5-11 in. to 39 ft., Dia in. to ft., Dia in. to ft.
 Casing height above land surface: 12 in., weight class 160 lbs./ft. Wall thickness or gauge No. 2/4

TYPE OF SCREEN OR PERFORATION MATERIAL:
 1 Steel 3 Stainless steel 5 Fiberglass 7 PVC 10 Asbestos-cement
 2 Brass 4 Galvanized steel 6 Concrete tile 8 RMP (SR) 11 Other (specify)
 9 ABS 12 None used (open hole)

SCREEN OR PERFORATION OPENINGS ARE:
 1 Continuous slot 3 Mill slot 5 Gauzed wrapped 8 Saw cut 11 None (open hole)
 2 Louvered shutter 4 Key punched 6 Wire wrapped 9 Drilled holes
 7 Torch cut 10 Other (specify)

SCREEN-PERFORATED INTERVALS: From 39 ft. to 59 ft., From ft. to ft.
 GRAVEL PACK INTERVALS: From ft. to ft., From ft. to ft.
 From ft. to ft., From ft. to ft.

GROUT MATERIAL: 1 Neat cement 2 Cement grout 3 Bentonite 4 Other
 Grout intervals: From 0 ft. to 20 ft., From ft. to ft., From ft. to ft.

What is the nearest source of possible contamination:
 1 Septic tank 4 Lateral lines 7 Pit privy 10 Livestock pens 14 Abandoned water well
 2 Sewer lines 5 Cess pool 8 Sewage lagoon 11 Fuel storage 15 Oil well/Gas well
 3 Watertight sewer lines 6 Seepage pit 9 Feedyard 12 Fertilizer storage 16 Other (specify below)
 13 Insecticide storage
 Direction from well? W How many feet? 50 +

FROM	TO	LITHOLOGIC LOG	FROM	TO	PLUGGING INTERVALS
0	21	Clay mixed shale			
21	48	Gray shale			
48	49	Water			
49	59	Blue shale			

CONTRACTOR'S OR LANDOWNER'S CERTIFICATION: This water well was (1) constructed (2) reconstructed, or (3) plugged under my jurisdiction and was completed on (mo/day/year) 4-8-94 and this record is true to the best of my knowledge and belief. Kansas Water Well Contractor's License No. 180 This Water Well Record was completed on (mo/day/yr) 4-8-94 under the business name of Backhus Drilling by (signature) Paul H. Backhus

OFFICE USE ONLY