


1 LOCATION OF WATER WELL: Fraction SE 1/4 NE 1/4 Section Number 19 Township Number T 20 S Range Number R 3 EW  
 County: Marion  
 Distance and direction from nearest town or city street address of well if located within city?  
4 E 3/4 S Hillspore

2 WATER WELL OWNER: Lawrence Winkley  
 RR# , St. Address, Box # : RR 2  
 City, State, ZIP Code : Hillspore KS  
 Board of Agriculture, Division of Water Resources  
 Application Number:

3 LOCATE WELL'S LOCATION WITH AN "X" IN SECTION BOX:  
 4 DEPTH OF COMPLETED WELL 52 ft. ELEVATION:  
 Depth(s) Groundwater Encountered 1. 1 ft. 2. 25 ft. 3. 4-21-82 ft.

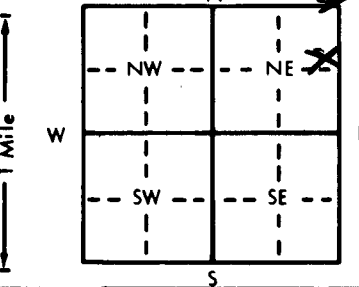

WELL'S STATIC WATER LEVEL 25 ft. below land surface measured on mo/day/yr 4-21-82  
 Pump test data: Well water was 25 ft. after 7 hours pumping 25 gpm  
 Est. Yield 25 gpm Well water was 15 ft. after 7 hours pumping 52 gpm  
 Bore Hole Diameter 9 in. to 15 ft. and 7 in. to 52 ft.  
 WELL WATER TO BE USED AS:  
 5 Public water supply 8 Air conditioning 11 Injection well  
 1 Domestic 3 Feedlot 6 Oil field water supply 9 Dewatering 12 Other (Specify below)  
 2 Irrigation 4 Industrial 7 Lawn and garden only 10 Observation well  
 Was a chemical/bacteriological sample submitted to Department? Yes        No       ; If yes, mo/day/yr sample was submitted         
 Water Well Disinfected? Yes        No       

5 TYPE OF BLANK CASING USED:  
 1 Steel 3 RMP (SR) 5 Wrought iron 8 Concrete tile CASING JOINTS: Glued         Clamped         
 2 PVC 4 ABS 6 Asbestos-Cement 9 Other (specify below) Welded         
 Blank casing diameter 5 in. to 32 ft. Dia.        in. to        ft. Dia.        in. to        ft.  
 Casing height above land surface 12 in., weight Class 160 lbs./ft. Wall thickness or gauge No. 160  
 TYPE OF SCREEN OR PERFORATION MATERIAL:  
 1 Steel 3 Stainless steel 5 Fiberglass 7 PVC 10 Asbestos-cement  
 2 Brass 4 Galvanized steel 6 Concrete tile 8 RMP (SR) 11 Other (specify)         
 12 None used (open hole)  
 SCREEN OR PERFORATION OPENINGS ARE:  
 1 Continuous slot 3 Mill slot 5 Gauzed wrapped 8 Saw cut 11 None (open hole)  
 2 Louvered shutter 4 Key punched 6 Wire wrapped 9 Drilled holes  
 7 Torch cut 10 Other (specify)       

SCREEN-PERFORATED INTERVALS: From 32 ft. to 52 ft. From        ft. to        ft.  
 From        ft. to        ft. From        ft. to        ft.  
 GRAVEL PACK INTERVALS: From 10 ft. to 52 ft. From        ft. to        ft.  
 From        ft. to        ft. From        ft. to        ft.

6 GROUT MATERIAL: 1 Neat cement 2 Cement grout 3 Bentonite 4 Other         
 Grout Intervals: From 0 ft. to 10 ft., From        ft. to        ft., From        ft. to        ft.  
 What is the nearest source of possible contamination:  
 1 Septic tank 4 Lateral lines 7 Pit privy 10 Livestock pens 14 Abandoned water well  
 2 Sewer lines 5 Cess pool 8 Sewage lagoon 11 Fuel storage 15 Oil well/Gas well  
 3 Watertight sewer lines 6 Seepage pit 9 Feedyard 12 Fertilizer storage 16 Other (specify below)         
 13 Insecticide storage  
 Direction from well? S How many feet? 50 +

FROM	TO	LITHOLOGIC LOG	FROM	TO	LITHOLOGIC LOG
0	2	TOP Soil			
2	35	Yellow Clay			
35	45	Gray Clay + Shale			
45	46	Water			
46	52	Blue Shale			

7 CONTRACTOR'S OR LANDOWNER'S CERTIFICATION: This water well was (1) constructed (2) reconstructed, or (3) plugged under my jurisdiction and was completed on (mo/day/year) 4-22-82 and this record is true to the best of my knowledge and belief. Kansas Water Well Contractor's License No. 180 This Water Well Record was completed on (mo/day/yr) 4-22-82 under the business name of Boabbe Drilling by (signature) Paul Boabbe

INSTRUCTIONS: Use typewriter or ball point pen, PLEASE PRESS FIRMLY and PRINT clearly. Please fill in blanks, underline or circle the correct answers. Send top three copies to Kansas Department of Health and Environment, Division of Environment, Environmental Geology Section, Topeka, KS 66620. Send one to WATER WELL OWNER and retain one for your records.

OFFICE USE ONLY  
T 20 S R 3 EW  
SEC. 19  
SE 1/4 NE 1/4