USE TYPEWRITER OR BALL POINT PEN-PRESS FIRMLY, PRINT CLEARLY.

WATER WELL RECORD
KSA 82a-1201-1215

Kansas Department of Health and Environment-Division of Environment
(Water well Contractors)
Topeka, Kansas 66620

1. Location of well:	County: Marion	Fraction: SW 1/4 NE 1/4 SE 1/4	Section number: 19	Township number: T 20 S	Range number: R 3 E/W

2. Distance and direction from nearest town or city: 4 miles east
Street address of well location if in city: 4 south of Hillsboro

3. Owner of well: Harry Funk
R.R. or street: R.R. # 1
City, state, zip code: Marion, Kansas 66861

4. Locate with "X" in section below:

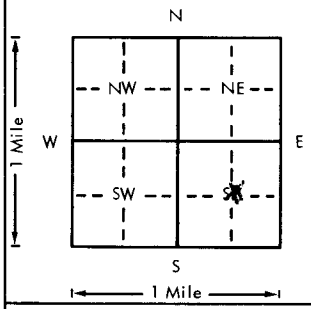

Sketch map:

6. Bore hole dia. 24" in. Completion date
Well depth 54 ft. 4/10/79

7. __ Cable tool __ Rotary __ Driven __ Dug
__ Hollow rod __ Jetted __ Bored X Reverse rotary

8. Use: __ Domestic __ Public supply __ Industry
X Irrigation __ Air conditioning __ Stock
__ Lawn __ Oil field water __ Other

9. Casing: Material transite Height: Above or below
Threaded bands Welded ___ Surface 12 in.
RMP ___ PVC ___ Weight ___ lbs./ft.
Dia. 16 in. to 54 ft. depth Wall Thickness: inches or
Dia. ___ in. to ___ ft. depth Gage No. 3/4

10. Screen: Manufacturer's name Johnson Well Casing
Type transite Dia. 16"
Slot/gauze 3/16 x 6 Length 26'
Set between 28 ft. and 54 ft.
___ ft. and ___ ft.
Gravel pack? Yes Size range of material 3/4 to 1"

11. Static water level: mo./day/yr.
7' ft. below land surface Date 4/10/79

12. Pumping level below land surfaces:
___ ft. after ___ hrs. pumping ___ g.p.m.
___ ft. after ___ hrs. pumping ___ g.p.m.
Estimated maximum yield 350 g.p.m.

13. Water sample submitted: mo./day/yr.
__ Yes X No Date

14. Well head completion:
__ Pitless adapter 12 Inches above grade

15. Well grouted? Yes
With: __ Neat cement X Bentonite __ Concrete
Depth: From 0 ft. to 10 ft.

16. Nearest source of possible contamination:
ft. 1,500 Direction north Type corral
Well disinfected upon completion? __ Yes X No

17. Pump: X Not installed
Manufacturer's name
Model number ___ HP ___ Volts ___
Length of drop pipe ___ ft. capacity ___ g.p.m.
Type:
__ Submersible __ Turbine
__ Jet __ Reciprocating
__ Centrifugal __ Other

5. Type and color of material	From	To
Lost log		
Main water at 37' in hard blue ahale		

(Use a second sheet if needed)

18. Elevation:
Topography:
__ Hill
__ Slope
__ Upland
__ Valley

19. Remarks:

20. Water well contractor's certification:
This well was drilled under my jurisdiction and this report is true to the best of my knowledge and belief.
Business name Rader Drilling Co. License No. 194
Address Carlton, Kansas 67429
Signed Brent C Rader Date 10-31-79
Authorized representative

T 20 R 3 E/W Sec 19 1/4 1/4 1/4 SWNE SE

Forward the white, blue and pink copies to the Department of Health and Environment

Form WWC-5

M1-1023