


1 LOCATION OF WATER WELL: County: Marion Fraction: SW 1/4 Me 1/4 NW 1/4 Section Number: 5 Township Number: T 19 20S Range Number: R 34 E/W

Distance and direction from nearest town or city street address of well if located within city?  
In City ~~Marion~~ Marion Freeborn St.

2 WATER WELL OWNER: Matthew Classen  
 RR#, St. Address, Box #: 702 S Actman Board of Agriculture, Division of Water Resources  
 City, State, ZIP Code: Marion, KS. 66861 Application Number:

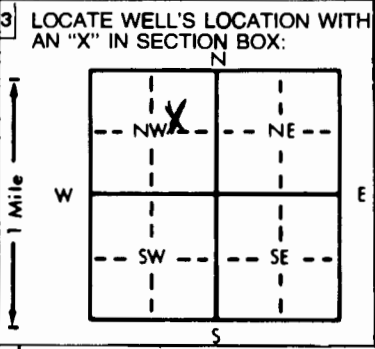

4 DEPTH OF COMPLETED WELL: 88 ft. ELEVATION:  
 Depth(s) Groundwater Encountered 1. 78 ft. 2. ft. 3. ft.  
 WELL'S STATIC WATER LEVEL 51 ft. below land surface measured on mo/day/yr 7-3-00  
 Pump test data: Well water was ft. after hours pumping gpm  
 Est. Yield 20 gpm; Well water was ft. after hours pumping gpm  
 Bore Hole Diameter: 2 1/2 in. to 2 1/2 ft. and in. to ft.  
 WELL WATER TO BE USED AS: 5 Public water supply 8 Air conditioning 11 Injection well  
 1 Domestic 3 Feedlot 6 Oil field water supply 9 Dewatering 12 Other (Specify below)  
 2 Irrigation 4 Industrial 7 Lawn and garden only 10 Monitoring well  
 Was a chemical/bacteriological sample submitted to Department? Yes No X; If yes, mo/day/yr sample was submitted  
 Water Well Disinfected? Yes X No

5 TYPE OF BLANK CASING USED:  
 1 Steel 3 RMP (SR) 5 Wrought iron 8 Concrete tile CASING JOINTS: Glued X Clamped  
 2 PVC 4 ABS 6 Asbestos-Cement 9 Other (specify below) Welded  
 7 Fiberglass Threaded  
 Blank casing diameter 5 in. to 6 1/2 ft. Dia. in. to ft. Dia. in. to ft.  
 Casing height above land surface 12 in., weight Class 160 lbs./ft. Wall thickness or gauge No. 2 1/4  
 TYPE OF SCREEN OR PERFORATION MATERIAL:  
 1 Steel 3 Stainless steel 5 Fiberglass 7 PVC 10 Asbestos-cement  
 2 Brass 4 Galvanized steel 6 Concrete tile 8 RMP (SR) 11 Other (specify)  
 9 ABS 12 None used (open hole)  
 SCREEN OR PERFORATION OPENINGS ARE:  
 1 Continuous slot 3 Mill slot 5 Gauzed wrapped 8 Saw cut 11 None (open hole)  
 2 Louvered shutter 4 Key punched 6 Wire wrapped 9 Drilled holes  
 7 Torch cut 10 Other (specify)  
 SCREEN-PERFORATED INTERVALS: From 6 1/2 ft. to 8 1/2 ft. From ft. to ft.  
 GRAVEL PACK INTERVALS: From 2 0 ft. to 8 1/2 ft. From ft. to ft.

6 GROUT MATERIAL: 1 Neat cement 2 Cement grout 3 Bentonite 4 Other  
 Grout Intervals: From 0 ft. to 2 ft., From ft. to ft., From ft. to ft.  
 What is the nearest source of possible contamination:  
 1 Septic tank 4 Lateral lines 7 Pit privy 10 Livestock pens 14 Abandoned water well  
 2 Sewer lines 5 Cess pool 8 Sewage lagoon 11 Fuel storage 15 Oil well/Gas well  
 3 Watertight sewer lines 6 Seepage pit 9 Feedyard 12 Fertilizer storage 16 Other (specify below)  
 13 Insecticide storage  
 Direction from well? E How many feet? 35

| FROM | TO | LITHOLOGIC LOG   | FROM | TO | PLUGGING INTERVALS |
|------|----|------------------|------|----|--------------------|
| 0    | 7  | Clay             |      |    |                    |
| 7    | 18 | lime             |      |    |                    |
| 18   | 40 | yellow Clay      |      |    |                    |
| 40   | 60 | Red Shale        |      |    |                    |
| 60   | 65 | yellow "         |      |    |                    |
| 65   | 78 | lime             |      |    |                    |
| 78   | 79 | Water            |      |    |                    |
| 79   | 88 | Gray Shale, Rock |      |    |                    |

7 CONTRACTOR'S OR LANDOWNER'S CERTIFICATION: This water well was (1) constructed, (2) reconstructed, or (3) plugged under my jurisdiction and was completed on (mo/day/year) 7-3-00 and this record is true to the best of my knowledge and belief. Kansas Water Well Contractor's License No. 180 This Water Well Record was completed on (mo/day/yr) 7-9-00 under the business name of Backhoe Drilling by (signature) Paul Backhoe

OFFICE USE ONLY  
T  
R  
E/W  
SEC.  
1/4  
1/4  
1/4