


1 LOCATION OF WATER WELL: County: Marion Fraction: Se 1/4 Sw 1/4 Se 1/4 Section Number: 9 Township Number: T 20 S Range Number: R 4 E

Distance and direction from nearest town or city, street address of well if located within city?  
1 1/2 E 2 Smart Lake Shore Dr. Marion County Lake

2 WATER WELL OWNER: Robert White  
 RR#, St. Address, Box #: 1440 N Gatewood  
 City, State, ZIP Code: Wichita, KS. 67206  
 Board of Agriculture, Division of Water Resources  
 Application Number:

3 LOCATE WELL'S LOCATION WITH AN "X" IN SECTION BOX:

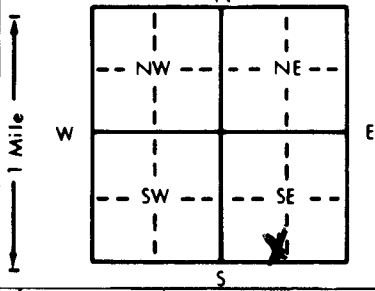

4 DEPTH OF COMPLETED WELL: 52 ft. ELEVATION:  
 Depth(s) Groundwater Encountered: 2 1/2 ft. 2. 17 ft. 3. 6-5-93 ft.  
 WELL'S STATIC WATER LEVEL: 17 ft. below land surface measured on 6-5-93 mo/day/yr  
 Pump test data: Well water was 25 gpm. Well water was 25 ft. after 2 1/2 hours pumping 25 gpm  
 Est. Yield: 25 gpm. Well water was 25 ft. after 2 1/2 hours pumping 25 gpm  
 Bore Hole Diameter: 2 1/2 in. to 52 ft., and 2 1/2 in. to 52 ft.  
 WELL WATER TO BE USED AS:  
 1 Domestic 25 3 Feedlot 6 Oil field water supply 9 Dewatering 11 Injection well  
 2 Irrigation 4 Industrial 7 Lawn and garden only 10 Monitoring well  
 Was a chemical/bacteriological sample submitted to Department? Yes X No X; If yes, mo/day/yr sample was submitted  
 Water Well Disinfected? Yes X No X

5 TYPE OF CASING USED:  
 1 Steel 3 RMP (SR) 5 Wrought iron 8 Concrete tile CASING JOINTS: Glued X Clamped X  
 2 PVC 4 ABS 6 Asbestos-Cement 9 Other (specify below) Welded X  
 7 Fiberglass Threaded X

Blank casing diameter: 3 in. to 35 ft. Dia. 12 in. to 160 lbs./ft. Wall thickness or gauge No. 219

TYPE OF SCREEN OR PERFORATION MATERIAL:  
 1 Steel 3 Stainless steel 5 Fiberglass 7 PVC 10 Asbestos-cement  
 2 Brass 4 Galvanized steel 6 Concrete tile 8 RMP (SR) 11 Other (specify)  
 9 ABS 12 None used (open hole)

SCREEN OR PERFORATION OPENINGS ARE:  
 1 Continuous slot 3 Mill slot 5 Gauzed wrapped 8 Saw cut 11 None (open hole)  
 2 Louvered shutter 4 Key punched 6 Wire wrapped 9 Drilled holes  
 7 Torch cut 10 Other (specify)

SCREEN-PERFORATED INTERVALS: From 35 ft. to 52 ft. From 35 ft. to 52 ft.  
 GRAVEL PACK INTERVALS: From 23 ft. to 52 ft. From 23 ft. to 52 ft.

6 GROUT MATERIAL: 1 Neat cement 2 Cement grout 3 Bentonite 4 Other  
 Grout Intervals: From 3 ft. to 23 ft. From 3 ft. to 23 ft.

What is the nearest source of possible contamination:  
 1 Septic tank 4 Lateral lines 7 Pit privy 10 Livestock pens 14 Abandoned water well  
 2 Sewer lines 5 Cess pool 8 Sewage lagoon 11 Fuel storage 15 Oil well/Gas well  
 3 Watertight sewer lines 6 Seepage pit 9 Feedyard 12 Fertilizer storage 16 Other (specify below)  
 13 Insecticide storage

Direction from well? N How many feet? Approx 50'

FROM	TO	LITHOLOGIC LOG	FROM	TO	PLUGGING INTERVALS
0	3	Clay			
3	25	lime			
25	40	Red Shale			
25	47	lime			
47	48	Water			
48	52	Gray Rock			

7 CONTRACTOR'S OR LANDOWNER'S CERTIFICATION: This water well was (1) constructed, (2) reconstructed, or (3) plugged under my jurisdiction and was completed on (mo/day/year) 6-5-93 and this record is true to the best of my knowledge and belief. Kansas Water Well Contractor's License No. 120 This Water Well Record was completed on (mo/day/yr) 6-14-93 under the business name of Backhus Drilling by (signature) Paul H. Backhus

INSTRUCTIONS: Use typewriter or ball point pen. PLEASE PRESS FIRMLY and PRINT clearly. Please fill in blanks, underline or circle the correct answers. Send top three copies to Kansas Department of Health and Environment, Bureau of Water, Topeka, Kansas 66620-0001. Telephone: 913-296-5545. Send one to WATER WELL OWNER and retain one for your records.