


1 LOCATION OF WATER WELL: Fraction SW 1/4 SW 1/4 SW 1/4 Section Number 4 Township Number T 20 S Range Number R 4 E
 County: Marion

Distance and direction from nearest town or city street address of well if located within city?
1 mi S, 5 mi E. from Marion, Kansas 66861

2 WATER WELL OWNER: Earl Winter
 RR#, St. Address, Box #: 606 S. Freeborn,
 City, State, ZIP Code: Marion, Kansas 66861
 Board of Agriculture, Division of Water Resources
 Application Number: NA

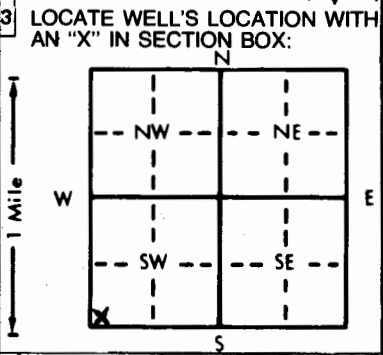

4 DEPTH OF COMPLETED WELL: 72 ft. ELEVATION: _____
 Depth(s) Groundwater Encountered 1. 62 ft. 2. _____ ft. 3. _____ ft.
 WELL'S STATIC WATER LEVEL 28.5 ft. below land surface measured on mo/day/yr 3-27-85
 Pump test data: Well water was 63 ft. after 1/2 hours pumping 25 gpm
 Est. Yield 30+ gpm: Well water was _____ ft. after _____ hours pumping _____ gpm
 Bore Hole Diameter 8 in. to 72 ft., and _____ in. to _____ ft.
 WELL WATER TO BE USED AS:
 1 Domestic 3 Feedlot 6 Oil field water supply 9 Dewatering 11 Injection well
 2 Irrigation 4 Industrial 7 Lawn and garden only 10 Observation well
 Was a ~~chemical~~ bacteriological sample submitted to Department? Yes No ; If yes, mo/day/yr sample was submitted 2-22-85
 Water Well Disinfected? Yes No

5 TYPE OF BLANK CASING USED:
 1 Steel 3 RMP (SR) 6 Asbestos-Cement 9 Other (specify below) _____
 2 PVC 4 ABS 7 Fiberglass _____
 Blank casing diameter 5 in. to 47 ft., Dia. _____ in. to _____ ft., Dia. _____ in. to _____ ft.
 Casing height above land surface 20 in., weight 2 lb. 6 oz. lbs./ft. Wall thickness or gauge No. 15
 TYPE OF SCREEN OR PERFORATION MATERIAL:
 1 Steel 3 Stainless steel 5 Fiberglass 8 RMP (SR) 11 Other (specify) _____
 2 Brass 4 Galvanized steel 6 Concrete tile 9 ABS 12 None used (open hole)
 SCREEN OR PERFORATION OPENINGS ARE:
 1 Continuous slot 3 Mill slot 6 Wire wrapped 8 Saw cut 11 None (open hole)
 2 Louvered shutter 4 Key punched 7 Torch cut 10 Other (specify) _____
 SCREEN-PERFORATED INTERVALS: From 47 ft. to 72 ft., From _____ ft. to _____ ft.
 From _____ ft. to _____ ft., From _____ ft. to _____ ft.
 GRAVEL PACK INTERVALS: From 45 ft. to 72 ft., From _____ ft. to _____ ft.
 From _____ ft. to _____ ft., From _____ ft. to _____ ft.

6 GROUT MATERIAL: 1 Neat cement 2 Cement grout 3 Bentonite 4 Other Filled with cutting
 Grout Intervals: From 2.5 ft. to 20 ft., From (4) 20 ft. to 45 ft., From _____ ft. to _____ ft.
 What is the nearest source of possible contamination:
 1 Septic tank 4 Lateral lines 7 Pit privy 10 Livestock pens 14 Abandoned water well
 2 Sewer lines 5 Cess pool 8 Sewage lagoon 11 Fuel storage 15 Oil well/Gas well
 3 Watertight sewer lines 6 Seepage pit 9 Feedyard 12 Fertilizer storage 16 Other (specify below) _____
 13 Insecticide storage _____
 Direction from well? S.E. How many feet? 115

FROM	TO	LITHOLOGIC LOG	FROM	TO	LITHOLOGIC LOG
0	7	Clay - Brown			
7	19	Limestone + Clay Layers - Yellow			
19	30	Lime - Gray White			
30	36	Rock - Flint - Very Hard			
36	42	Shale - Med. Blue			
42	48	Red Bed - Red			
48	58	Water Bearing Gravel			
58	69				
69	72	Shale - Med. Blue			

7 CONTRACTOR'S OR LANDOWNER'S CERTIFICATION: This water well was (1) constructed, (2) reconstructed, or (3) plugged under my jurisdiction and was completed on (mo/day/year) 3-27-85 and this record is true to the best of my knowledge and belief. Kansas Water Well Contractor's License No. 161 This Water Well Record was completed on (mo/day/yr) 3-30-85 under the business name of Benda Drilling by (signature) Paul W. Benda

INSTRUCTIONS: Use typewriter or ball point pen, PLEASE PRESS FIRMLY and PRINT clearly. Please fill in blanks, underline or circle the correct answers. Send top three copies to Kansas Department of Health and Environment, Division of Environment, Environmental Geology Section, Topeka, KS 66620. Send one to WATER WELL