


1 LOCATION OF WATER WELL: Fraction Ne 1/4 Me 1/4 Me 1/4 Section Number 5 Township Number T 20 N S Range Number R 4 E N
 County: Marion

Distance and direction from nearest town or city street address of well if located within city?
In City Marion, 202 Meadow Lane

2 WATER WELL OWNER: Max Hayden
 RR#, St. Address, Box #: 202 Meadow Lane Board of Agriculture, Division of Water Resources
 City, State, ZIP Code: Marion, KS 66861 Application Number:

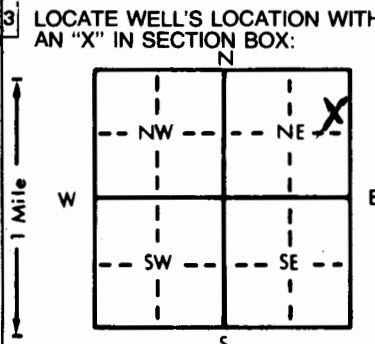

4 DEPTH OF COMPLETED WELL: 61 ft. ELEVATION:
 Depth(s) Groundwater Encountered 1. 54 ft. 2. ft. 3. ft.
 WELL'S STATIC WATER LEVEL: 12 ft. below land surface measured on mo/day/yr 1-6-86
 Pump test data: Well water was ft. after hours pumping gpm
 Est. Yield 30 gpm Well water was ft. after hours pumping gpm
 Bore Hole Diameter: 8 1/2 in. to 6 1/2 in. to in. to in. to ft.
 WELL WATER TO BE USED AS:
 5 Public water supply 8 Air conditioning 11 Injection well
 1 Domestic 3 Feedlot 6 Oil field water supply 9 Dewatering 12 Other (Specify below)
 2 Irrigation 4 Industrial 7 Lawn and garden only 10 Observation well
 Was a chemical/bacteriological sample submitted to Department? Yes.....No X.....; If yes, mo/day/yr sample was submitted
 Water Well Disinfected? Yes X No

5 TYPE OF BLANK CASING USED:
 1 Steel 3 RMP (SR) 5 Wrought iron 8 Concrete tile CASING JOINTS: Glued X Clamped
 2 PVC 4 ABS 6 Asbestos-Cement 9 Other (specify below) Welded
 7 Fiberglass Threaded
 Blank casing diameter: 5 in. to 4 1/2 ft. Dia. in. to in. to in. to in. to ft.
 Casing height above land surface: 12 in., weight 0.1289 lbs./ft. Wall thickness or gauge No. 2.14
 TYPE OF SCREEN OR PERFORATION MATERIAL:
 1 Steel 3 Stainless steel 5 Fiberglass 8 RMP (SR) 10 Asbestos-cement
 2 Brass 4 Galvanized steel 6 Concrete tile 9 ABS 11 Other (specify)
 12 None used (open hole)
 SCREEN OR PERFORATION OPENINGS ARE:
 1 Continuous slot 3 Mill slot 5 Gauzed wrapped 8 Saw cut 11 None (open hole)
 2 Louvered shutter 4 Key punched 6 Wire wrapped 9 Drilled holes
 7 Torch cut 10 Other (specify)
 SCREEN-PERFORATED INTERVALS: From 45 ft. to 61 ft., From ft. to ft. to ft.
 From ft. to ft., From ft. to ft. to ft.
 GRAVEL PACK INTERVALS: From 10 ft. to 60 ft., From ft. to ft. to ft.
 From ft. to ft., From ft. to ft. to ft.

6 GROUT MATERIAL: 1 Neat cement 2 Cement grout 3 Bentonite 4 Other
 Grout Intervals: From 0 ft. to 10 ft., From ft. to ft. to ft., From ft. to ft. to ft.
 What is the nearest source of possible contamination:
 1 Septic tank 4 Lateral lines 7 Pit privy 11 Fuel storage 14 Abandoned water well
 2 Sewer lines 5 Cess pool 8 Sewage lagoon 12 Fertilizer storage 15 Oil well/Gas well
 3 Watertight sewer lines 6 Seepage pit 9 Feedyard 13 Insecticide storage 16 Other (specify below)
 Direction from well? E How many feet? 20

| FROM | TO | LITHOLOGIC LOG | FROM | TO | LITHOLOGIC LOG |
|-----------|-----------|-------------------|------|----|----------------|
| <u>0</u> | <u>12</u> | <u>lime</u> | | | |
| <u>12</u> | <u>19</u> | <u>Clay</u> | | | |
| <u>19</u> | <u>30</u> | <u>lime</u> | | | |
| <u>30</u> | <u>43</u> | <u>Red Shale</u> | | | |
| <u>43</u> | <u>54</u> | <u>Gray Shale</u> | | | |
| <u>54</u> | <u>55</u> | <u>Water</u> | | | |
| <u>55</u> | <u>61</u> | <u>Gray Shale</u> | | | |

7 CONTRACTOR'S OR LANDOWNER'S CERTIFICATION: This water well was (1) constructed, (2) reconstructed, or (3) plugged under my jurisdiction and was completed on (mo/day/year) 1-6-85 and this record is true to the best of my knowledge and belief. Kansas Water Well Contractor's License No. 180 This Water Well Record was completed on (mo/day/yr) 1-28-85 under the business name of Backhus Drilling by (signature) Paul H. Backhus

INSTRUCTIONS: Use typewriter or ball point pen, PLEASE PRESS FIRMLY and PRINT clearly. Please fill in blanks, underline or circle the correct answers. Send top three copies to Kansas Department of Health and Environment, Division of Environment, Environmental Geology Section, Topeka, KS 66620. Send one to WATER WELL