


1 LOCATION OF WATER WELL: County: Marion Fraction: Ne 1/4 Sw 1/4 Se 1/4 Section Number: 9 Township Number: T 20 S Range Number: R 4 E

Distance and direction from nearest town or city street address of well if located within city?
2 E 1 1/2 S Marion At County Lake

2 WATER WELL OWNER: Don Cox
 RR#, St. Address, Box #: 345 Broadway Board of Agriculture, Division of Water Resources
 City, State, ZIP Code: El Dorado Mo. 67042 Application Number:

3 LOCATE WELL'S LOCATION WITH AN "X" IN SECTION BOX:

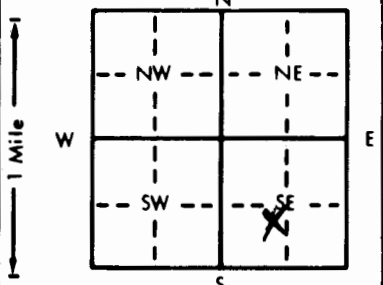

4 DEPTH OF COMPLETED WELL: 56 ft. ELEVATION:

Depth(s) Groundwater Encountered 1. 10 55 ft. 2. ft. 3. ft.
 WELL'S STATIC WATER LEVEL 10 55 ft. below land surface measured on mo/day/yr 10-6-23
 Pump test data: Well water was ft. after hours pumping gpm
 Est. Yield 30 gpm; Well water was ft. after hours pumping gpm
 Bore Hole Diameter 9 in. to 15 ft., and 7 in. to ft.
 WELL WATER TO BE USED AS: 5 Public water supply 8 Air conditioning 11 Injection well
 1 Domestic 3 Feedlot 6 Oil field water supply 9 Dewatering 12 Other (Specify below)
 2 Irrigation 4 Industrial 7 Lawn and garden only 10 Observation well
 Was a chemical/bacteriological sample submitted to Department? Yes.....No X.....; If yes, mo/day/yr sample was submitted
 Water Well Disinfected? Yes X No

5 TYPE OF BLANK CASING USED: 5 Wrought iron 8 Concrete tile CASING JOINTS: Glued X Clamped.....
 1 Steel 3 RMP (SR) 6 Asbestos-Cement 9 Other (specify below) Welded.....
 2 PVC 4 ABS 7 Fiberglass Threaded.....

Blank casing diameter 3 3/8 in. to 3 3/8 ft., Dia in. to ft., Dia in. to ft.
 Casing height above land surface 12 3/8 in., weight 9.12 lbs./ft. Wall thickness or gauge No. 2.14

TYPE OF SCREEN OR PERFORATION MATERIAL: 7 PVC 10 Asbestos-cement
 1 Steel 3 Stainless steel 5 Fiberglass 8 RMP (SR) 11 Other (specify).....
 2 Brass 4 Galvanized steel 6 Concrete tile 9 ABS 12 None used (open hole)

SCREEN OR PERFORATION OPENINGS ARE: 5 Gauzed wrapped 8 Saw cut 11 None (open hole)
 1 Continuous slot 3 Mill slot 6 Wire wrapped 9 Drilled holes
 2 Louvered shutter 4 Key punched 7 Torch cut 10 Other (specify).....

SCREEN-PERFORATED INTERVALS: From 36 ft. to 56 ft., From ft. to ft. ft. to ft.
 From ft. to ft. ft. to ft. ft. to ft.
 GRAVEL PACK INTERVALS: From 13 ft. to 56 ft., From ft. to ft. ft. to ft.

6 GROUT MATERIAL: 1 Neat cement 3 2 Cement grout 13 3 Bentonite 4 Other.....
 Grout Intervals: From 3 ft. to 13 ft., From ft. to ft. ft. to ft. ft. to ft.

What is the nearest source of possible contamination: 10 Livestock pens 14 Abandoned water well
 1 Septic tank 4 Lateral lines 7 Pit privy 11 Fuel storage 15 Oil well/Gas well
 2 Sewer lines 5 Cess pool 8 Sewage lagoon 12 Fertilizer storage 16 Other (specify below)
 3 Watertight sewer lines 6 Seepage pit 9 Feedyard 13 Insecticide storage Holding Tank
 Direction from well? N W How many feet? 30

FROM	TO	LITHOLOGIC LOG	FROM	TO	LITHOLOGIC LOG
0	3	Rock			
3	10	Clay			
10	22	Lime Stone			
22	53	Yellow + Red Shale			
53	56	Water			

7 CONTRACTOR'S OR LANDOWNER'S CERTIFICATION: This water well was (1) constructed, (2) reconstructed, or (3) plugged under my jurisdiction and was completed on (mo/day/year) 10-2-23 and this record is true to the best of my knowledge and belief. Kansas Water Well Contractor's License No. 100 This Water Well Record was completed on (mo/day/yr) under the business name of Baerhus Drilling by (signature)

INSTRUCTIONS: Use typewriter or ball point pen, PLEASE PRESS FIRMLY and PRINT clearly. Please fill in blanks, underline or circle the correct answers. Send top three copies to Kansas Department of Health and Environment, Division of Environment, Environmental Geology Section, Topeka, KS 66609. Good luck! WATER WELL

OFFICE USE ONLY
T
R
E
S
E