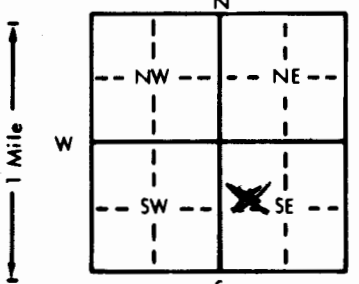


1 LOCATION OF WATER WELL: Fraction SW 1/4 NW 1/4 SE 1/4 Section Number 10 Township Number T 20 S Range Number R 7 E
 County: Marion

Distance and direction from nearest town or city street address of well if located within city?
1/2 E 2 S Marion Co. County lake

2 WATER WELL OWNER: Lowell Wilder
 RR#, St. Address, Box #: Lake Shore Dr Board of Agriculture, Division of Water Resources
 City, State, ZIP Code: Marion Ks. 66861 Application Number:

3 LOCATE WELL'S LOCATION WITH AN "X" IN SECTION BOX:


4 DEPTH OF COMPLETED WELL: 75 ft. ELEVATION:
 Depth(s) Groundwater Encountered 1. 55 ft. 2. 70 ft. 3. ft.
 WELL'S STATIC WATER LEVEL ft. below land surface measured on mo/day/yr
 Pump test data: Well water was ft. after hours pumping gpm
 Est. Yield 25 gpm Well water was ft. after hours pumping gpm
 Bore Hole Diameter 9 in. to 20 ft., and 8 in. to 75 ft.
 WELL WATER TO BE USED AS:
 5 Public water supply 8 Air conditioning 11 Injection well
 1 Domestic 3 Feedlot 6 Oil field water supply 9 Dewatering 12 Other (Specify below)
 2 Irrigation 4 Industrial 7 Lawn and garden only 10 Observation well
 Was a chemical/bacteriological sample submitted to Department? Yes No X; If yes, mo/day/yr sample was submitted
 Water Well Disinfected? Yes X No

5 TYPE OF BLANK CASING USED:
 1 Steel 3 RMP (SR) 5 Wrought iron 8 Concrete tile CASING JOINTS: Glued X Clamped
 2 PVC 4 ABS 6 Asbestos-Cement 9 Other (specify below) Welded
 7 Fiberglass Threaded
 Blank casing diameter 5 in. to 55 ft., Dia. in. to ft., Dia. in. to ft.
 Casing height above land surface 12 in., weight 12.89/160 lbs./ft. Wall thickness or gauge No. 2/4
 TYPE OF SCREEN OR PERFORATION MATERIAL:
 1 Steel 3 Stainless steel 5 Fiberglass 7 PVC 10 Asbestos-cement
 2 Brass 4 Galvanized steel 6 Concrete tile 8 RMP (SR) 11 Other (specify)
 9 ABS 12 None used (open hole)
 SCREEN OR PERFORATION OPENINGS ARE:
 1 Continuous slot 3 Mill slot 5 Gauzed wrapped 8 Saw cut 11 None (open hole)
 2 Louvered shutter 4 Key punched 6 Wire wrapped 9 Drilled holes
 7 Torch cut 10 Other (specify)
 SCREEN-PERFORATED INTERVALS: From 55 ft. to 75 ft., From ft. to ft.
 From ft. to ft., From ft. to ft.
 GRAVEL PACK INTERVALS: From 12 ft. to 75 ft., From ft. to ft.
 From ft. to ft., From ft. to ft.

6 GROUT MATERIAL: 1 Neat cement 2 Cement grout 3 Bentonite 4 Other
 Grout Intervals: From 2 ft. to 12 ft., From ft. to ft., From ft. to ft.
 What is the nearest source of possible contamination:
 1 Septic tank 4 Lateral lines 7 Pit privy 10 Livestock pens 14 Abandoned water well
 2 Sewer lines 5 Cess pool 8 Sewage lagoon 11 Fuel storage 15 Oil well/Gas well
 3 Watertight sewer lines 6 Seepage pit 9 Feedyard 12 Fertilizer storage 16 Other (specify below)
 13 Insecticide storage
 Direction from well? W How many feet? 50

FROM	TO	LITHOLOGIC LOG	FROM	TO	LITHOLOGIC LOG
0	2	Top Soil			
2	25	lime Stone			
25	40	Yellow Shale + Clay			
40	55	Red Shale			
55	70	lime			
70	71	Water			
71	75	Gray Rock			

7 CONTRACTOR'S OR LANDOWNER'S CERTIFICATION: This water well was (1) constructed, (2) reconstructed, or (3) plugged under my jurisdiction and was completed on (mo/day/year) 5-29-85 and this record is true to the best of my knowledge and belief. Kansas Water Well Contractor's License No. 100 This Water Well Record was completed on (mo/day/yr) 5-25-85 under the business name of Backhoe Drilling by (signature) Paul Backhoe

INSTRUCTIONS: Use typewriter or ball point pen, PLEASE PRESS FIRMLY and PRINT clearly. Please fill in blanks, underline or circle the correct answers. Send top three copies to Kansas Department of Health and Environment, Division of Environment, Environmental Geology Section, Topeka, KS 66620. Send one to WATER WELL