


1 LOCATION OF WATER WELL: Fraction Se 1/4 NW 1/4 NW 1/4 Section Number 10 Township Number T 20 S Range Number R 0-4 E
 County: Marion

Distance and direction from nearest town or city street address of well if located within city?
1 1/2 E 1 1/4 S Marion At Marion County Lake 74 Lake Shore Dr.

2 WATER WELL OWNER: Rich Turner
 RR#, St. Address, Box #: RR2 Board of Agriculture, Division of Water Resources
 City, State, ZIP Code: Marion, KS Application Number:

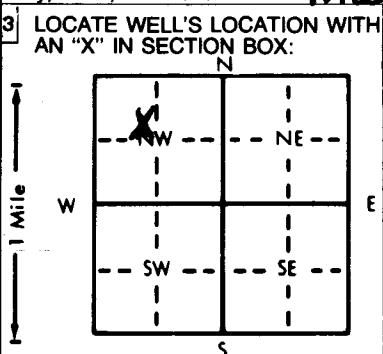

4 DEPTH OF COMPLETED WELL: 66 ft. ELEVATION:
 Depth(s) Groundwater Encountered 24 ft. 2. 58 ft. 3.
 WELL'S STATIC WATER LEVEL 24 ft. below land surface measured on mo/day/yr 3-29-89
 Pump test data: Well water was _____ ft. after _____ hours pumping _____ gpm
 Est. Yield 30 gpm Well water was _____ ft. after _____ hours pumping _____ gpm
 Bore Hole Diameter 2 1/2 in. to 66 ft., and _____ in. to _____ ft.
 WELL WATER TO BE USED AS:
 1 Domestic 3 Feedlot 6 Oil field water supply 9 Dewatering 12 Other (Specify below)
 2 Irrigation 4 Industrial 7 Lawn and garden only 10 Monitoring well
 Was a chemical/bacteriological sample submitted to Department? Yes _____ No X; If yes, mo/day/yr sample was submitted _____
 Water Well Disinfected? Yes X No

5 TYPE OF BLANK CASING USED:
 1 Steel 3 RMP (SR) 5 Wrought iron 8 Concrete tile CASING JOINTS: Glued Clamped _____
 2 PVC 4 ABS 6 Asbestos-Cement 9 Other (specify below) Welded _____
 7 Fiberglass Threaded _____
 Blank casing diameter 5 in. to 46 ft., Dia _____ in. to _____ ft., Dia _____ in. to _____ ft.
 Casing height above land surface 12 in., weight Class 160 lbs./ft. Wall thickness or gauge No. 2.14
 TYPE OF SCREEN OR PERFORATION MATERIAL:
 1 Steel 3 Stainless steel 5 Fiberglass 8 RMP (SR) 10 Asbestos-cement 11 Other (specify) _____
 2 Brass 4 Galvanized steel 6 Concrete tile 9 ABS 12 None used (open hole)
 SCREEN OR PERFORATION OPENINGS ARE:
 1 Continuous slot 3 Mill slot 5 Gauzed wrapped 8 Saw cut 11 None (open hole)
 2 Louvered shutter 4 Key punched 6 Wire wrapped 9 Drilled holes
 7 Torch cut 10 Other (specify) _____
 SCREEN-PERFORATED INTERVALS: From 46 ft. to 66 ft., From _____ ft. to _____ ft., From _____ ft. to _____ ft.
 GRAVEL PACK INTERVALS: From _____ ft. to _____ ft., From _____ ft. to _____ ft., From _____ ft. to _____ ft.

6 GROUT MATERIAL: 1 Neat cement 2 Cement grout 3 Bentonite 4 Other Hole Plug
 Grout Intervals: From 0 ft. to 26 ft., From _____ ft. to _____ ft., From _____ ft. to _____ ft.
 What is the nearest source of possible contamination:
 1 Septic tank 4 Lateral lines 7 Pit privy 11 Fuel storage 14 Abandoned water well
 2 Sewer lines 5 Cess pool 8 Sewage lagoon 12 Fertilizer storage 15 Oil well/Gas well
 3 Watertight sewer lines 6 Seepage pit 9 Feedyard 13 Insecticide storage 16 Other (specify below) _____
 Direction from well? S How many feet? 25

FROM	TO	LITHOLOGIC LOG	FROM	TO	PLUGGING INTERVALS
<u>0</u>	<u>23</u>	<u>lime</u>			
<u>23</u>	<u>32</u>	<u>yellow Clay</u>			
<u>32</u>	<u>57</u>	<u>Red Shale</u>			
<u>57</u>	<u>58</u>	<u>Water</u>			
<u>58</u>	<u>66</u>	<u>Blue Shale & Gray Rock</u>			

7 CONTRACTOR'S OR LANDOWNER'S CERTIFICATION This water well was (1) constructed, (2) reconstructed, or (3) plugged under my jurisdiction and was completed on (mo/day/year) 3-29-89 and this record is true to the best of my knowledge and belief. Kansas Water Well Contractor's License No. 180 This Water Well Record was completed on (mo/day/yr) 4-9-89 under the business name of Backhus Drilling by (signature) Paul H. Backhus