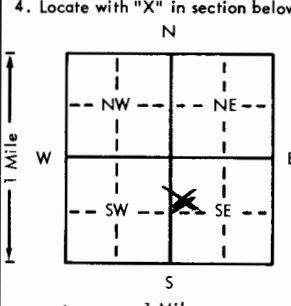


USE TYPEWRITER OR BALL POINT PEN—PRESS FIRMLY, PRINT CLEARLY.

WATER WELL RECORD  
KSA 82a-1201-1215

Kansas Department of Health and Environment—Division of Environment  
(Water well Contractors)  
Topeka, Kansas 66620

1. Location of well: County <u>Marion</u> Fraction <u>SW 1/4 NW 1/4 SE 1/4</u> Section number <u>10</u> Township number <u>T 20 S R 4</u> Range number <u>4</u> <span style="float:right;">(E-W)</span>	
2. Distance and direction from nearest town or city: <u>1 E 2 S</u> Street address of well location if in city: <u>Marion</u> 3. Owner of well: <u>Gerry Harris</u> R.R. or street: City, state, zip code: <u>Marion, Ks.</u>	
4. Locate with "X" in section below: Sketch map: 	
5. Type and color of material	
	From To
<u>yellow shale</u>	<u>0 6</u>
<u>lime stone</u>	<u>6 37</u>
<u>yellow shale + clay</u>	<u>37 52</u>
<u>some water</u>	<u>52 53</u>
<u>lime stone</u>	<u>53 62</u>
<u>Hard Gray Rock</u>	<u>62 68</u>
<u>water</u>	<u>68 69</u>
<u>Gray Rock</u>	<u>69 73</u>
(Use a second sheet if needed)	
18. Elevation: Topography: <input type="checkbox"/> Hill <input checked="" type="checkbox"/> Slope <input type="checkbox"/> Upland <input type="checkbox"/> Valley	19. Remarks:
6. Bore hole dia <u>9-7</u> in. Completion date <u>5-2-78</u> Well depth <u>73</u> ft.	
7. <input checked="" type="checkbox"/> Cable tool <input type="checkbox"/> Rotary <input type="checkbox"/> Driven <input type="checkbox"/> Dug <input type="checkbox"/> Hollow rod <input type="checkbox"/> Jetted <input type="checkbox"/> Bored <input type="checkbox"/> Reverse rotary	
8. Use: <input checked="" type="checkbox"/> Domestic <input type="checkbox"/> Public supply <input type="checkbox"/> Industry <input type="checkbox"/> Irrigation <input type="checkbox"/> Air conditioning <input type="checkbox"/> Stock <input type="checkbox"/> Lawn <input type="checkbox"/> Oil field water <input type="checkbox"/> Other	
9. Casing: Material <u>PVC</u> Height: <u>0</u> or below Threaded <input type="checkbox"/> Welded <input type="checkbox"/> Surface <u>72</u> in. RMP <input type="checkbox"/> PVC <input checked="" type="checkbox"/> Weight <u>2450</u> lbs./ft. Dia. <u>5</u> in. to <u>73</u> ft. depth Wall Thickness: inches or Dia. <u>in.</u> to <u>ft.</u> depth gage No. <u>250+</u>	
10. Screen: Manufacturer's name <u>A.S.T.M.</u> Type <u>PVC</u> Dia. <u>5"</u> Slot/gauze <u>5</u> Length <u>20</u> Set between <u>50</u> ft. and <u>60</u> ft. <u>68</u> ft. and <u>73</u> ft. Gravel pack? <input checked="" type="checkbox"/> Size range of material <u>38</u>	
11. Static water level: <u>38</u> ft. below land surface Date <u>mo./day/yr.</u>	
12. Pumping level below land surfaces: <u>   </u> ft. after <u>   </u> hrs. pumping <u>   </u> g.p.m. <u>   </u> ft. after <u>   </u> hrs. pumping <u>   </u> g.p.m. Estimated maximum yield <u>   </u> g.p.m.	
13. Water sample submitted: <u>   </u> mo./day/yr. Yes <input checked="" type="checkbox"/> No <input type="checkbox"/> Date <u>   </u>	
14. Well head completion: <u>in Basement</u> <input type="checkbox"/> Pitless adapter <u>   </u> inches above grade	
15. Well grouted? <input checked="" type="checkbox"/> With: <input checked="" type="checkbox"/> Neat cement <input type="checkbox"/> Bentonite <input type="checkbox"/> Concrete Depth: From <u>0</u> ft. to <u>10</u> ft.	
16. Nearest source of possible contamination: <u>60+</u> ft. Direction <u>N</u> Type <u>Septic tank</u> Well disinfected upon completion? <input checked="" type="checkbox"/> Yes <input type="checkbox"/> No	
17. Pump: <input checked="" type="checkbox"/> Not installed Manufacturer's name <u>   </u> Model number <u>   </u> HP <u>   </u> Volts <u>   </u> Length of drop pipe <u>   </u> ft. capacity <u>   </u> g.p.m. Type: <input type="checkbox"/> Submersible <input type="checkbox"/> Turbine <input type="checkbox"/> Jet <input type="checkbox"/> Reciprocating <input type="checkbox"/> Centrifugal <input type="checkbox"/> Other	
20. Water well contractor's certification: This well was drilled under my jurisdiction and this report is true to the best of my knowledge and belief. <u>Boekhus Drg. 180</u> Business name <u>Tampa Ks</u> License No. <u>   </u> Address <u>   </u> Signed <u>Paul Boekhus</u> Date <u>5-12-78</u> Authorized representative	

20 4 0  
10 SW 1/4 SE  
1/4 1/4 1/4