

1 LOCATION OF WATER WELL: Fraction SE 1/4 NE 1/4 SW 1/4 Section Number 14 Township Number T 20 S Range Number R 4 E/W

Distance and direction from nearest town or city street address of well if located within city? 3455' S of 170th St. & 2140' E of Hwy 77, Marion


2 WATER WELL OWNER: Peterson Feedlot

RR#, St. Address, Box #: 1624 N. Hwy 77

City, State, ZIP Code: Marion, Kansas 66861

Board of Agriculture, Division of Water Resources Application Number:

3 LOCATE WELL'S LOCATION WITH AN "X" IN SECTION BOX:

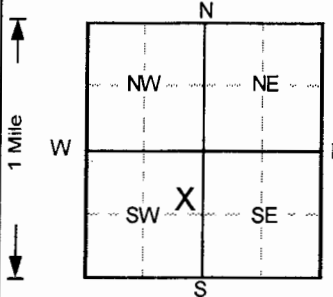

4 DEPTH OF COMPLETED WELL: 36 ft. ELEVATION: ... WELL'S STATIC WATER LEVEL: ... Pump test data: ... Est. Yield: ... Bore Hole Diameter: 6.25 in. to 36 ft. ... WELL WATER TO BE USED AS: ... Monitoring well

5 TYPE OF BLANK CASING USED: 2 PVC ... 5 Wrought iron ... 8 Concrete tile ... CASING JOINTS: Threaded

Blank casing diameter: 2 in. to 26 ft. Dia. ... Casing height above land surface: 18 in., weight: ... lbs./ft. Wall thickness or gauge No. Sch. 40

TYPE OF SCREEN OR PERFORATION MATERIAL: 7 PVC ... 10 Asbestos-cement ... 11 Other (specify) ... 12 None used (open hole)

SCREEN OR PERFORATION OPENINGS ARE: 3 Mill slot ... 5 Gauzed wrapped ... 8 Saw cut ... 11 None (open hole)

SCREEN-PERFORATED INTERVALS: From 26 ft to 36 ft ... GRAVEL PACK INTERVALS: From 24 ft to 36 ft

6 GROUT MATERIAL: 4 Other Concrete ... GROUT INTERVALS: From 0 ft to 3 ft, From 3 ft to 24 ft

What is the nearest source of possible contamination: 10 Livestock pens, 14 Abandoned water well, 15 Oil well/Gas well, 16 Other (specify below)

LITHOLOGIC LOG and PLUGGING INTERVALS table with columns FROM, TO, and descriptions of soil layers.

7 CONTRACTOR'S OR LANDOWNER'S CERTIFICATION: This water well was (1) constructed, (2) reconstructed, or (3) plugged under my jurisdiction and was completed on (mo/day/year) 1/18/2013 and this record is true to the best of my knowledge and belief.

INSTRUCTIONS: Use typewriter or ball point pen. PLEASE PRESS FIRMLY and PRINT clearly. Please fill in blanks, underline or circle the correct answers.