


1 LOCATION OF WATER WELL: County: Marion Fraction: Ne 1/4 Ne 1/4 Ne 1/4 Section, Number: 19 Township, Number: T 20S Range Number: R 50E

Distance and direction from nearest town or city street address of well if located within city?  
3 N 1/2 E Florence

2 WATER WELL OWNER: Floyd Siebert  
RR#, St. Address, Box #: RR Board of Agriculture, Division of Water Resources  
City, State, ZIP Code: Marion, Ks. Application Number:

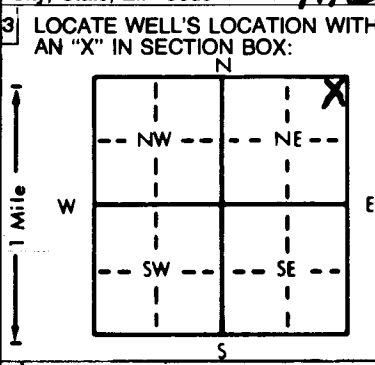

4 DEPTH OF COMPLETED WELL: 130 ft. ELEVATION:  
Depth(s) Groundwater Encountered 1. 59.3 ft. 2. ft. 3. ft.  
WELL'S STATIC WATER LEVEL: 59 ft. below land surface measured on mo/day/yr 5-30-09  
Pump test data: Well water was ft. after hours pumping gpm  
Est. Yield 1 1/2 gpm; Well water was ft. after hours pumping gpm  
Bore Hole Diameter: 2 1/2 in. to 25 ft., and 7 in. to 130 ft.  
WELL WATER TO BE USED AS:  
5 Public water supply 8 Air conditioning 11 Injection well  
1 Domestic 3 Feedlot 6 Oil field water supply 9 Dewatering 12 Other (Specify below)  
2 Irrigation 4 Industrial 7 Lawn and garden only 10 Monitoring well  
Was a chemical/bacteriological sample submitted to Department? Yes.....No.....X.....; If yes, mo/day/yr sample was submitted Water Well Disinfected? Yes X No

5 TYPE OF BLANK CASING USED:  
1 Steel 3 RMP (SR) 5 Wrought iron 8 Concrete tile CASING JOINTS: Glued X Clamped  
2 PVC 4 ABS 6 Asbestos-Cement 9 Other (specify below) Welded  
7 Fiberglass Threaded  
Blank casing diameter 5 in. to 80 ft., Dia. in. to ft., Dia. in. to ft.  
Casing height above land surface: 12 in., weight CLASS 160 lbs./ft. Wall thickness or gauge No. 214  
TYPE OF SCREEN OR PERFORATION MATERIAL:  
1 Steel 3 Stainless steel 5 Fiberglass 7 PVC 10 Asbestos-cement  
2 Brass 4 Galvanized steel 6 Concrete tile 8 RMP (SR) 11 Other (specify)  
12 None used (open hole)  
SCREEN OR PERFORATION OPENINGS ARE:  
1 Continuous slot 3 Mill slot 5 Gauzed wrapped 8 Saw cut 11 None (open hole)  
2 Louvered shutter 4 Key punched 6 Wire wrapped 9 Drilled holes  
3 Torch cut 10 Other (specify)  
SCREEN-PERFORATED INTERVALS: From 80 ft. to 130 ft., From ft. to ft.  
GRAVEL PACK INTERVALS: From ft. to ft., From ft. to ft.

6 GROUT MATERIAL: 1 Neat cement 2 Cement grout 3 Bentonite 4 Other  
Grout Intervals: From 0 ft. to 20 ft., From ft. to ft., From ft. to ft.  
What is the nearest source of possible contamination:  
1 Septic tank 4 Lateral lines 7 Pit privy 10 Livestock pens 14 Abandoned water well  
2 Sewer lines 5 Cess pool 8 Sewage lagoon 11 Fuel storage 15 Oil well/Gas well  
3 Watertight sewer lines 6 Seepage pit 9 Feedyard 12 Fertilizer storage 16 Other (specify below)  
13 Insecticide storage  
Direction from well? In pasture for Cattle How many feet?

FROM	TO	LITHOLOGIC LOG	FROM	TO	PLUGGING INTERVALS
0	4	Clay			
4	53	lime & mixed shale			
53	93	Gray Rock + Blue l			
93	94	Water			
94	130	Gray Rock			

7 CONTRACTOR'S OR LANDOWNER'S CERTIFICATION: This water well was (1) constructed, (2) reconstructed, or (3) plugged under my jurisdiction and was completed on (mo/day/year) 5-30-09 and this record is true to the best of my knowledge and belief. Kansas Water Well Contractor's License No. 180 This Water Well Record was completed on (mo/day/yr) 5-31-09 under the business name of Bachhus Drilling by (signature) Gaul H. Bachhus