


1 LOCATION OF WATER WELL: County: Chase Fraction: NE 1/4 NW 1/4 SE 1/4 Section Number: 11 Township Number: T 20 S Range Number: R 6 EW

Distance and direction from nearest town or city street address of well if located within city?
1 mile North Clements Ks

2 WATER WELL OWNER: Chuck Magathan
 RR#, St. Address, Box #: 670B 170 Rd. Board of Agriculture, Division of Water Resources
 City, State, ZIP Code: Cedar Point Ks 66843 Application Number: NA

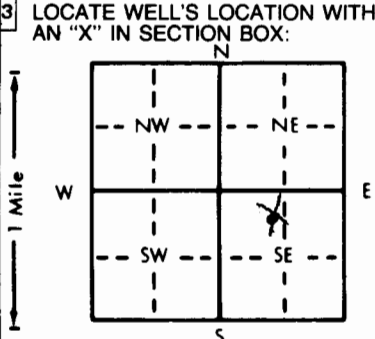

4 DEPTH OF COMPLETED WELL: 160' ft. ELEVATION: _____ ft.
 Depth(s) Groundwater Encountered 1. 68' ft. 2. _____ ft. 3. _____ ft.
 WELL'S STATIC WATER LEVEL: 58' ft. below land surface measured on mo/day/yr 6-10-08
 Pump test data: Well water was _____ ft. after _____ hours pumping _____ gpm
 Est. Yield: 5 gpm: Well water was _____ ft. after _____ hours pumping _____ gpm
 Bore Hole Diameter: 14 in. to 22 in. and 13 in. to 100 in. ft.
 WELL WATER TO BE USED AS:
 5 Public water supply 8 Air conditioning 11 Injection well
 1 Domestic (3) Feedlot 6 Oil field water supply 9 Dewatering 12 Other (Specify below)
 2 Irrigation 4 Industrial 7 Lawn and garden only 10 Monitoring well
 Was a chemical/bacteriological sample submitted to Department? Yes _____ No X If yes, mo/day/yr sample was submitted _____
 Water Well Disinfected? Yes X No _____

5 TYPE OF BLANK CASING USED:
 1 Steel 3 RMP (SR) 5 Wrought iron 8 Concrete tile CASING JOINTS: Glued X Clamped _____
 2 PVC 4 ABS 6 Asbestos-Cement 9 Other (specify below) Welded _____
 7 Fiberglass _____ Threaded _____
 Blank casing diameter: 10 in. to 1.60 ft., Dia _____ in. to _____ ft., Dia _____ in. to _____ ft.
 Casing height above land surface: _____ in., weight _____ lbs./ft. Wall thickness or gauge No. _____
 TYPE OF SCREEN OR PERFORATION MATERIAL:
 1 Steel 3 Stainless steel 5 Fiberglass 8 RMP (SR) 10 Asbestos-cement 11 Other (specify) _____
 2 Brass 4 Galvanized steel 6 Concrete tile 9 ABS 12 None used (open hole)
 SCREEN OR PERFORATION OPENINGS ARE:
 1 Continuous slot 3 Mill slot 5 Gauzed wrapped 8 Saw cut 11 None (open hole)
 2 Louvered shutter 4 Key punched 6 Wire wrapped 9 Drilled holes
 7 Torch cut 10 Other (specify) _____
 SCREEN-PERFORATED INTERVALS: From 50' ft. to 160' ft., From _____ ft. to _____ ft.
 From _____ ft. to _____ ft., From _____ ft. to _____ ft.
 GRAVEL PACK INTERVALS: From _____ ft. to _____ ft., From _____ ft. to _____ ft.
 From _____ ft. to _____ ft., From _____ ft. to _____ ft.

6 GROUT MATERIAL: (1) Neat cement 2 Cement grout (3) Bentonite 4 Other _____
 Grout Intervals: From 5 ft. to 20 ft. From 25 ft. to _____ ft. From _____ ft. to _____ ft.
 What is the nearest source of possible contamination:
 1 Septic tank 4 Lateral lines 7 Pit privy (10) Livestock pens 14 Abandoned water well
 2 Sewer lines 5 Cess pool 8 Sewage lagoon 11 Fuel storage 15 Oil well/Gas well
 3 Watertight sewer lines 6 Seepage pit 9 Feedyard 12 Fertilizer storage 16 Other (specify below) _____
 13 Insecticide storage _____
 Direction from well? South Down Grade How many feet? 100

FROM	TO	LITHOLOGIC LOG	FROM	TO	PLUGGING INTERVALS
0	3	TS	130	145	Sh variegated
3	23	Lime	145	148	Chert
23	29	Sh Gray	148	160	Sh lite gray
29	37	Sh Red			
37	50	Sh Gray Calc			
50	55	Lime Brown			
55	67	Lime Gray Water 62			
67	85	Sh BIK WT 58			
85	90	Lime Dense			
90	96	Broken Lime + Sh Gray			
96	100	Sh Calc.			
100	108	Sh coal seam			
108	120	Lime Gray Hard			
120	130	Sh Calc Gray			

7 CONTRACTOR'S OR LANDOWNER'S CERTIFICATION: This water well was X constructed, (2) reconstructed, or (3) plugged under my jurisdiction and was completed on (mo/day/year) 6-15-08 and this record is true to the best of my knowledge and belief. Kansas Water Well Contractor's License No. 203 This Water Well Record was completed on (mo/day/yr) 6-19-08 under the business name of MONEE Drilling & Metals by (signature) JC McNew

INSTRUCTIONS: Use typewriter or ball point pen. PLEASE PRESS FIRMLY and PRINT clearly. Please fill in blanks, underline or circle the correct answers. Send top three copies to Kansas Department of Health and Environment, Bureau of Water, Topeka, Kansas 66620-0001. Telephone: 913-296-5545. Send one to WATER WELL OWNER and retain one for your records.