

WATER WELL RECORD

Form WWC-5


Division of Water Resources App. No.

1 LOCATION OF WATER WELL: County: CHASE	Fraction <i>NE 1/4 SE 1/4 SW 1/4</i>	Section Number <i>14</i>	Township No. T <i>20</i> S	Range Number R <i>6</i> <input checked="" type="checkbox"/> E <input type="checkbox"/> W
---------------------------------------------------	-----------------------------------------	-----------------------------	-------------------------------	---------------------------------------------------------------------------------------------

Street/Rural Address of Well Location; if unknown, distance & direction from nearest town or intersection: If at owner's address, check here .

Global Positioning System (GPS) information:
 Latitude: (in decimal degrees)
 Longitude: (in decimal degrees)
 Elevation:
 Datum: WGS 84, NAD 83, NAD 27
 Collection Method:
 GPS unit (Make/Model:)
 Digital Map/Photo, Topographic Map, Land Survey
 Est. Accuracy: <3 m, 3-5 m, 5-15 m, >15 m

2 WATER WELL OWNER: HARSHMAN CONSTRUCTION
 RR#, Street Address, Box #: 1648 FP ROAD
 City, State, ZIP Code : CEDAR POINT, KANSAS 66843

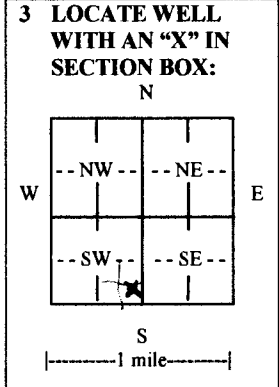

4 DEPTH OF COMPLETED WELL *Plugged* 200 ft. *5 300' Bores*

Depth(s) Groundwater Encountered (1) *NONE* ft. (2) ft. (3) ft.

WELL'S STATIC WATER LEVEL ft. below land surface measured on mo/day/yr.

Pump test data: Well water was ft. after hours pumping gpm

EST. YIELD 0 gpm. Well water was ft. after hours pumping gpm

Bore Hole Diameter *6* in. to *200* ft., and in. to ft.

WELL WATER TO BE USED AS: Public water supply Geothermal Injection well
 Domestic Feedlot Oil field water supply Dewatering Other (Specify below)
 Irrigation Industrial Domestic-lawn & garden Monitoring well CLOSED LOOP

Was a chemical/bacteriological sample submitted to Department? Yes No

If yes, mo/day/yr sample was submitted.....

Water well disinfected? Yes No

5 TYPE OF CASING USED: Steel PVC Other *H.D. POLYETHYLENE*

CASING JOINTS: Glued Clamped Welded Threaded *Fusion*

Casing diameter *3/4* in. to *200* ft., Diameter in. to ft., Diameter in. to ft.

Casing height *below* above land surface *36* in., Weight *SDR11* lbs./ft., Wall thickness or gauge No. *160PSI*

TYPE OF SCREEN OR PERFORATION MATERIAL: *None*

Steel Stainless Steel PVC Other (Specify)

Brass Galvanized Steel None used (open hole)

SCREEN OR PERFORATION OPENINGS ARE: *None*

Continuous slot Mill slot Gauze wrapped Torch cut Drilled holes None (open hole)
 Louvered shutter Key punched Wire wrapped Saw cut Other (specify)

SCREEN-PERFORATED INTERVALS: From ft. to ft., From ft. to ft.
 From ft. to ft., From ft. to ft.

GRAVEL PACK INTERVALS: From ft. to ft., From ft. to ft.
 From ft. to ft., From ft. to ft.

6 GROUT MATERIAL: Neat cement Cement grout Bentonite Other

Grout Intervals: From *200* ft. to *3* ft., From ft. to ft., From ft. to ft.

What is the nearest source of possible contamination:

Septic tank Lateral lines Pit privy Livestock pens Insecticide storage Other (specify below)
 Sewer lines Cesspool Sewage lagoon Fuel storage Abandoned water well
 Watertight sewer lines Seepage pit Feedyard Fertilizer storage Oil well/gas well

Direction from well Distance from well

FROM	TO	LITHOLOGIC LOG	FROM	TO	LITHO. LOG (cont.) or PLUGGING INTERVALS
0	22	SOIL/CLAY			
22	38	RED SHALE			
38	54	SHALE			
54	56	LIME			
56	124	SHALE	200	3	5-200' BORES PLUGGED WITH
124	126	LIME			HIGH SOLID BENTONITE
126	180	SHALE			
180	184	LIME			
184	200	SHALE			

7 CONTRACTOR'S OR LANDOWNER'S CERTIFICATION: This water well was constructed, reconstructed, or plugged under my jurisdiction and was completed on (mo/day/year) *8-4-14* and this record is true to the best of my knowledge and belief. Kansas Water Well Contractor's License No. *561* This Water Well Record was completed on (mo/day/year) *8-5-14* under the business name of *EVANS ENERGY DEVELOPMENT, INC.* by (signature) *[Signature]*

INSTRUCTIONS: Use typewriter or ball point pen. *PLEASE PRESS FIRMLY* and *PRINT* clearly. Please fill in blanks and check the correct answers. Send one copy to Kansas Department of Health and Environment, Bureau of Water, Geology Section, 1000 SW Jackson St., Suite 420, Topeka, Kansas 66612-1367. Telephone 785-296-5524. Send one copy to WATER WELL OWNER and retain one for your records. Include fee of \$5.00 for each constructed well. Visit us at