


1 LOCATION OF WATER WELL: County: Chase Fraction: SE 1/4 SW 1/4 NW 1/4 Section Number: 3 Township Number: T 20 S Range Number: R 6 E

Distance and direction from nearest town or city street address of well if located within city?
North 2 1/2 South. 1/2 East Clements KS. WEST

2 WATER WELL OWNER: Panther Ranch. RR#, St. Address, Box #: 9301 Mission Rd City, State, ZIP Code: Suite 323 Frank Village KS 66208 Board of Agriculture, Division of Water Resources Application Number: NA

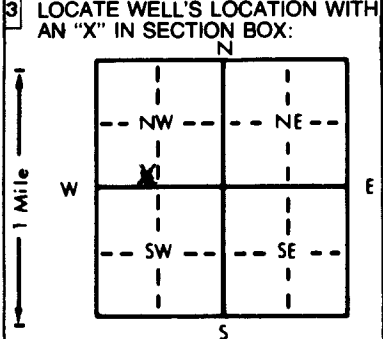

4 DEPTH OF COMPLETED WELL: 157 ft. ELEVATION:
 Depth(s) Groundwater Encountered 1. 35-40 ft. 2. ft. 3. ft.
 WELL'S STATIC WATER LEVEL 11 ft. below land surface measured on mo/day/yr 9-26-94
 Pump test data: Well water was ft. after hours pumping gpm
 Est. Yield 1/2 gpm: Well water was ft. after hours pumping gpm
 Bore Hole Diameter in. to ft., and in. to ft.
 WELL WATER TO BE USED AS: 5 Public water supply 8 Air conditioning 11 Injection well
 Domestic 3 Feedlot 6 Oil field water supply 9 Dewatering 12 Other (Specify below)
 2 Irrigation 4 Industrial 7 Lawn and garden only 10 Monitoring well
 Was a chemical/bacteriological sample submitted to Department? Yes No If yes, mo/day/yr sample was submitted
 Water Well Disinfected? Yes No

5 TYPE OF BLANK CASING USED: 1 Steel 3 RMP (SR) 5 Wrought iron 8 Concrete tile CASING JOINTS: Glued Clamped
 PVC 4 ABS 6 Asbestos-Cement 9 Other (specify below) Welded
 7 Fiberglass Threaded
 Blank casing diameter 6 in. to 157 ft. Dia in. to ft. Dia in. to ft.
 Casing height above land surface 3 in. weight 160 lbs./ft. Wall thickness or gauge No.
 TYPE OF SCREEN OR PERFORATION MATERIAL: PVC 10 Asbestos-cement
 1 Steel 3 Stainless steel 5 Fiberglass 8 RMP (SR) 11 Other (specify)
 2 Brass 4 Galvanized steel 6 Concrete tile 9 ABS 12 None used (open hole)
 SCREEN OR PERFORATION OPENINGS ARE: 5 Gauzed wrapped 8 Saw cut 11 None (open hole)
 1 Continuous slot 3 Mill slot 6 Wire wrapped Drilled holes
 2 Louvered shutter 4 Key punched 7 Torch cut 10 Other (specify)
 SCREEN-PERFORATED INTERVALS: From 20 ft. to 155 ft. From ft. to ft.
 From ft. to ft. From ft. to ft.
 GRAVEL PACK INTERVALS: From ft. to ft. From ft. to ft.
 From ft. to ft. From ft. to ft.

6 GROUT MATERIAL: 1 Neat cement 2 Cement grout Bentonite 4 Other
 Grout Intervals: From 0 ft. to 20 ft. From ft. to ft. From ft. to ft.
 What is the nearest source of possible contamination: 10 Livestock pens Abandoned water well
 1 Septic tank 4 Lateral lines 7 Pit privy 11 Fuel storage 15 Oil well/Gas well
 2 Sewer lines 5 Cess pool 8 Sewage lagoon 12 Fertilizer storage 16 Other (specify below)
 3 Watertight sewer lines 6 Seepage pit 9 Feedyard 13 Insecticide storage
 Direction from well? EAST How many feet? 30

FROM	TO	LITHOLOGIC LOG	FROM	TO	PLUGGING INTERVALS
0	13	Clay w Gravel Bnn.	105	125	Sh Red & Green
13	13.5	Flint Rock.	125	138	lime & sh Gray
13.5	17	Sh Lt Gray.	138	139	Sh Black.
17	24	Sh Blue	139	157	Sh w lime Gray.
24	27	Lime w chert Dense			
27	27.5	Break.			
27.5	30	Lime med Dense			
30	35	Sh Gray Green.			
35	40	Sh w Box work. H ₂ O			
40	45	Sh Calc.			
45	69	Sh w Lime Lens Variegated			
69	90	Sh Variegated.			
90	102	Sh Red			
102	105	Lime on Box work			

7 CONTRACTOR'S OR LANDOWNER'S CERTIFICATION: This water well was constructed, (2) reconstructed, or (3) plugged under my jurisdiction and was completed on (mo/day/year) 12-10-94 and this record is true to the best of my knowledge and belief. Kansas Water Well Contractor's License No. 203 This Water Well Record was completed on (mo/day/yr) 12-30-94 under the business name of M & N Drilling & Metals. by (signature) [Signature]

INSTRUCTIONS: Use typewriter or ball point pen. PLEASE PRESS FIRMLY and PRINT clearly. Please fill in blanks, underline or circle the correct answers. Send top three copies to Kansas Department of Health and Environment, Bureau of Water, Topeka, Kansas 66620-0001. Telephone: 913-296-5545. Send one to WATER WELL OWNER and retain one for your records.

000345