


1 LOCATION OF WATER WELL: County: Chase Fraction: NW 1/4 SE 1/4 NE 1/4 Section Number: 35 Township Number: T 20 S Range Number: R 7 E

Distance and direction from nearest town or city street address of well if located within city? 5 miles West Bazzan

2 WATER WELL OWNER: 5 Creeks Ranch
 RR#, St. Address, Box #: 2720 Venauacircle
 City, State, ZIP Code: Shawnee Mission 66208
 Board of Agriculture, Division of Water Resources
 Application Number: NA

3 LOCATE WELL'S LOCATION WITH AN "X" IN SECTION BOX:

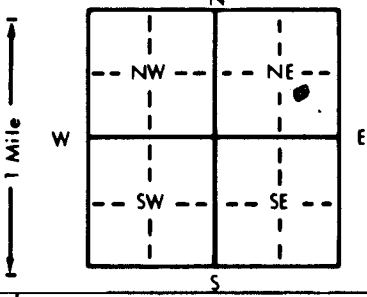

4 DEPTH OF COMPLETED WELL: 100 ft. ELEVATION: 1329.20

Depth(s) Groundwater Encountered 1. 1 ft. 2. Above ft. 3. 1 ft.
 WELL'S STATIC WATER LEVEL 1 ft. Above land surface measured on mo/day/yr 7-10-95

Pump test data: Well water was 12 gpm ft. after 8 hours pumping 8 gpm
 Est. Yield 12 gpm Well water was 100 ft. after 8 hours pumping 8 gpm

Bore Hole Diameter: 8 in. to 100 ft., and 8 in. to 100 ft.
 WELL WATER TO BE USED AS:
 1 Domestic 3 Feedlot 6 Oil field water supply 9 Dewatering 12 Other (Specify below)
 2 Irrigation 4 Industrial 7 Lawn and garden only 10 Monitoring well

Was a chemical/bacteriological sample submitted to Department? Yes X No X; If yes, mo/day/yr sample was submitted
 Water Well Disinfected? Yes X No X

5 TYPE OF BLANK CASING USED:
 1 Steel 3 RMP (SR) 5 Wrought iron 8 Concrete tile CASING JOINTS: Glued X Clamped X
 2 PVC 4 ABS 6 Asbestos-Cement 9 Other (specify below) Welded X
 7 Fiberglass Threaded X


TYPE OF SCREEN OR PERFORATION MATERIAL:
 1 Steel 3 Stainless steel 5 Fiberglass 8 RMP (SR) 10 Asbestos-cement 11 Other (specify) NA
 2 Brass 4 Galvanized steel 6 Concrete tile 9 ABS 12 None used (open hole)

SCREEN OR PERFORATION OPENINGS ARE:
 1 Continuous slot 3 Mill slot 5 Gauzed wrapped 8 Saw cut 11 None (open hole)
 2 Louvered shutter 4 Key punched 6 Wire wrapped 9 Drilled holes
 7 Torch cut 10 Other (specify) NA


6 GROUT MATERIAL: 1 Neat cement 2 Cement grout 3 Bentonite 4 Other

What is the nearest source of possible contamination:
 1 Septic tank 4 Lateral lines 7 Pit privy 10 Livestock pens 14 Abandoned water well
 2 Sewer lines 5 Cess pool 8 Sewage lagoon 11 Fuel storage 15 Oil well/Gas well
 3 Watertight sewer lines 6 Seepage pit 9 Feedyard 12 Fertilizer storage 16 Other (specify below)
 13 Insecticide storage

Direction from well? How many feet?

FROM	TO	LITHOLOGIC LOG	FROM	TO	PLUGGING INTERVALS
100	60	Location, Flood Pool Area Site SOUTH FORK WS.			
60	55	3974. 92 Feet U.S. Sta 8+50 G DAM.			
55	6				
6	3	Bailed down hole filled with well pack to 60' Dumped			
3	0	2 Bags quick set concrete. Filled to 28' with well pack. Dumped 2 Bags Enviro Plug. Drove Down plug with tools. Filled to top of Bed Rock. With neat cement. Broke off casing at top of Bed rock. Filled to surface. Clay material.			
		This well produced from open hole & probably 2 zones top at 32' Lower zone probably in the 90-100' Area.			Bed Rock Florencels

7 CONTRACTOR'S OR LANDOWNER'S CERTIFICATION: This water well was (1) constructed, (2) reconstructed, or (3) plugged under my jurisdiction and was completed on (mo/day/year) 7-11-95 and this record is true to the best of my knowledge and belief. Kansas Water Well Contractor's License No. 203 This Water Well Record was completed on (mo/day/yr) 7-27-95 under the business name of McNe Drilling & Metals by (signature) J. O. White