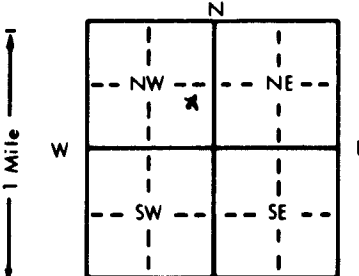


1 LOCATION OF WATER WELL: County: Chase Fraction: NE 1/4 SE 1/4 NW 1/4 Section Number: 5 Township Number: T 20 S Range Number: R 7 E/W

Distance and direction from nearest town or city street address of well if located within city?
2 3/4 mile SW of Elmdale

2 WATER WELL OWNER: Raymond Barrett
 RR#, St. Address, Box #: RE1 Box 27 Board of Agriculture, Division of Water Resources
 City, State, ZIP Code: Cottonwood Falls, Ks 66850 Application Number:

3 LOCATE WELL'S LOCATION WITH AN "X" IN SECTION BOX:


4 DEPTH OF COMPLETED WELL: 46 ft. ELEVATION:
 Depth(s) Groundwater Encountered 1. 18 ft. 2. ft. 3. ft.
 WELL'S STATIC WATER LEVEL: 7 ft. below land surface measured on mo/day/yr Apr. 2. 94
 Pump test data: Well water was ft. after hours pumping gpm
 Est. Yield: 8.5 gpm; Well water was ft. after hours pumping gpm
 Bore Hole Diameter: 9 in. to 30 ft., and 7 in. to 46 ft.
 WELL WATER TO BE USED AS:
 Domestic 3 Feedlot 6 Oil field water supply 9 Dewatering 12 Other (Specify below)
 Irrigation 4 Industrial 7 Lawn and garden only 10 Monitoring well
 Was a chemical/bacteriological sample submitted to Department? Yes No X; If yes, mo/day/yr sample was submitted Water Well Disinfected? Yes No

5 TYPE OF BLANK CASING USED:
 1 Steel 3 RMP (SR) 5 Wrought iron 8 Concrete tile CASING JOINTS: Glued X Clamped
 2 PVC 4 ABS 7 Fiberglass Welded
 Blank casing diameter: 5 in. to 18 ft., Dia. in. to ft., Dia. in. to ft.
 Casing height above land surface: 18 in., weight lbs./ft. Wall thickness or gauge No. SDR-26
 TYPE OF SCREEN OR PERFORATION MATERIAL:
 7 PVC 10 Asbestos-cement
 1 Steel 3 Stainless steel 5 Fiberglass 8 RMP (SR) 11 Other (specify)
 2 Brass 4 Galvanized steel 6 Concrete tile 9 ABS 12 None used (open hole)
 SCREEN OR PERFORATION OPENINGS ARE:
 8 Saw cut 11 None (open hole)
 1 Continuous slot 3 Mill slot 6 Wire wrapped 9 Drilled holes
 2 Louvered shutter 4 Key punched 7 Torch cut 10 Other (specify)
 SCREEN-PERFORATED INTERVALS: From 18 ft. to 46 ft., From ft. to ft.
 GRAVEL PACK INTERVALS: From 17 ft. to 46 ft., From ft. to ft.

6 GROUT MATERIAL: 1 Neat cement 2 Cement grout 3 Bentonite 4 Other
 Grout Intervals: From 3 ft. to 17 ft., From ft. to ft.
 What is the nearest source of possible contamination:
 1 Septic tank 4 Lateral lines 7 Pit privy 10 Livestock pens 14 Abandoned water well
 2 Sewer lines 5 Cess pool 8 Sewage lagoon 11 Fuel storage 15 Oil well/Gas well
 3 Watertight sewer lines 6 Seepage pit 9 Feedyard 12 Fertilizer storage 16 Other (specify below)
 Direction from well? North How many feet? 60 Dry Ravine

FROM	TO	LITHOLOGIC LOG	FROM	TO	PLUGGING INTERVALS
0	5	Topsoil BLK			
5	16	Clay TAN			
16	19	Sandy Silt			
19	21	Gravel			
21	25	LIME Frac Lite			
25	33	Shale Lite Gray			
33	36	LIME Gray			
36	44	Shale DK Gray			
44	46	LIME Gray			

7 CONTRACTOR'S OR LANDOWNER'S CERTIFICATION: This water well was (1) constructed, (2) reconstructed, or (3) plugged under my jurisdiction and was completed on (mo/day/year) Apr. 2. 94 and this record is true to the best of my knowledge and belief. Kansas Water Well Contractor's License No. 218 This Water Well Record was completed on (mo/day/yr) Apr. 2. 94 under the business name of Zinn Water Well Drlg by (signature) Joseph A. Zinn

OFFICE USE ONLY
T
R
EW
SEC.
1/4
1/4
1/4