


1 LOCATION OF WATER WELL: County: **CHASE** Fraction: **NE 1/4 NE 1/4 SW 1/4** Section Number: **13** Township Number: **T 20 S** Range Number: **R 7 E**

Distance and direction from nearest town or city street address of well if located within city?
7 1/2 M - SW - COTTONWOOD FALLS. INS. 976 ST & Hwy. 57 - THEN SW on only Road.

2 WATER WELL OWNER: **JERRY BYRD**
 RR#, St. Address, Box #: **615 COTTONWOOD** Board of Agriculture, Division of Water Resources
 City, State, ZIP Code: **STRING CITY KS 66869** Application Number:

3 LOCATE WELL'S LOCATION WITH AN "X" IN SECTION BOX:

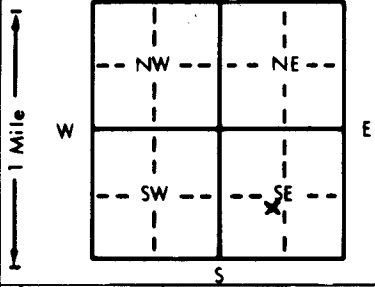

4 DEPTH OF COMPLETED WELL: **111** ft. ELEVATION: -
 Depth(s) Groundwater Encountered 1. **37** ft. 2. - ft. 3. - ft.
 WELL'S STATIC WATER LEVEL: **36** ft. below land surface measured on mo/day/yr **11-30-88**

Pump test data: Well water was **NA** ft. after - hours pumping - gpm
 Est. Yield **25** gpm: Well water was **NA** ft. after - hours pumping - gpm
 Bore Hole Diameter: **10** in. to **40** ft., and **8 3/8** in. to **111** ft.

WELL WATER TO BE USED AS:
 5 Public water supply 8 Air conditioning 11 Injection well
 1 Domestic 3 Feedlot 6 Oil field water supply 9 Dewatering
 2 Irrigation 4 Industrial 7 Lawn and garden only 10 Monitoring well **12 Other (Specify below)**
PASTURE SUPPLY

Was a chemical/bacteriological sample submitted to Department? Yes.....No. **X**.....; If yes, mo/day/yr sample was submitted
 Water Well Disinfected? Yes **X** No

5 TYPE OF BLANK CASING USED:
 1 Steel 3 RMP (SR) 5 Wrought iron 8 Concrete tile CASING JOINTS: Glued **X** Clamped
2 PVC 4 ABS 6 Asbestos-Cement 9 Other (specify below) Welded
 7 Fiberglass **NA** Threaded

Blank casing diameter: **6** in. to **111** ft., Dia. - in. to - ft., Dia. - in. to - ft.
 Casing height above land surface: **60"** in., weight **200** lbs./ft. Wall thickness or gauge No. **SC440**

TYPE OF SCREEN OR PERFORATION MATERIAL:
 1 Steel 3 Stainless steel 5 Fiberglass 7 **PVC** 10 Asbestos-cement
 2 Brass 4 Galvanized steel 6 Concrete tile 8 RMP (SR) 11 Other (specify)
 9 ABS 12 None used (open hole)

SCREEN OR PERFORATION OPENINGS ARE:
 1 Continuous slot 3 Mill slot 5 Gauzed wrapped 8 Saw cut 11 None (open hole)
 2 Louvered shutter 4 Key punched 6 Wire wrapped 9 Drilled holes
 7 Torch cut 10 Other (specify)

SCREEN-PERFORATED INTERVALS: From **51** ft. to **71** ft., From **91** ft. to **111** ft.
 GRAVEL PACK INTERVALS: From **NA** ft. to - ft., From - ft. to - ft.

6 GROUT MATERIAL: 1 Neat cement 2 Cement grout 3 Bentonite 4 Other
 Grout intervals: From **2 1/2** ft. to **24** ft., From - ft. to - ft., From - ft. to - ft.

What is the nearest source of possible contamination:
 1 Septic tank 4 Lateral lines 7 Pit privy 10 Livestock pens 14 Abandoned water well
 2 Sewer lines 5 Cess pool 8 Sewage lagoon 11 Fuel storage 15 Oil well/Gas well
 3 Watertight sewer lines 6 Seepage pit 9 Feedyard 12 Fertilizer storage 16 Other (specify below)
NONE IN SIGHT

Direction from well? - How many feet? -

FROM	TO	LITHOLOGIC LOG	FROM	TO	PLUGGING INTERVALS
0	2 1/2	TOP SOIL			
2 1/2	36	LIME			
36	38	VOID - WATER			
38	43	LIME			
43	70	SHALE			
70	73	LIME			
73	83	SHALE			
83	91	LIME - HARD			
91	100	SHALE LT GREY			
100	107	RED ROCK (PINK)			
107	110	SHALE LT GREY			
110	111	LIME TD			

7 CONTRACTOR'S OR LANDOWNER'S CERTIFICATION: This water well was (1) constructed, (2) reconstructed, or (3) plugged under my jurisdiction and was completed on (mo/day/year) **11-30-88** and this record is true to the best of my knowledge and belief. Kansas Water Well Contractor's License No. **479** This Water Well Record was completed on (mo/day/yr) **11-30-88** under the business name of **EBBERTS DRILLING** by (signature) **Arger Ebberts**