


1 LOCATION OF WATER WELL: County: **CHASE** Fraction: **C 1/4 - 1/4 SE 1/4** Section Number: **28** Township Number: **T 20 S** Range Number: **R 7 E**

Distance and direction from nearest town or city street address of well if located within city?
APPROX 10M - SW OF COTTONWOOD FLS. ON FAS 1077


2 WATER WELL OWNER: **MIKE STUDER**
 RR#, St. Address, Box #: **RR 1**
 City, State, ZIP Code: **COTTONWOOD KAN. 66845**
 Board of Agriculture, Division of Water Resources
 Application Number: -

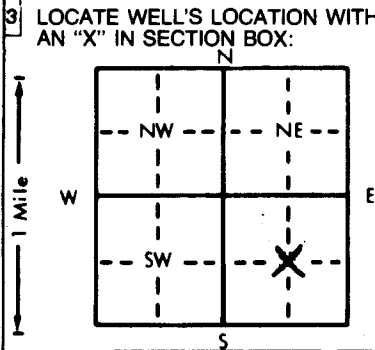

4 DEPTH OF COMPLETED WELL: **125** ft. ELEVATION: -
 Depth(s) Groundwater Encountered: 1. **UNKNDWN** ft. 2. - ft. 3. - ft.
 WELL'S STATIC WATER LEVEL: **7** ft. below land surface measured on mo/day/yr **09-09-89**
 Pump test data: Well water was - ft. after - hours pumping - gpm
 Est. Yield: **1** gpm; Well water was - ft. after - hours pumping - gpm
 Bore Hole Diameter: **8 3/4** in. to **125** ft., and - in. to - ft.
 WELL WATER TO BE USED AS:
 5 Public water supply 8 Air conditioning 11 Injection well
 1 Domestic 3 Feedlot 6 Oil field water supply 9 Dewatering 12 Other (Specify below)
 2 Irrigation 4 Industrial 7 Lawn and garden only 10 Monitoring well -
 Was a chemical/bacteriological sample submitted to Department? Yes - No **X**; If yes, mo/day/yr sample was submitted -
 Water Well Disinfected? Yes **X** No -

5 TYPE OF BLANK CASING USED:
 1 Steel 3 RMP (SR) 5 Wrought iron 8 Concrete tile CASING JOINTS: Glued **X** Clamped -
 2 PVC 4 ABS 6 Asbestos-Cement 9 Other (specify below) Welded -
 7 Fiberglass Threaded -
 Blank casing diameter: **5** in. to **125** ft., Dia - in. to - ft., Dia - in. to - ft.
 Casing height above land surface: *** -24** in., weight **160** lbs./ft. Wall thickness or gauge No. -
 TYPE OF SCREEN OR PERFORATION MATERIAL:
 1 Steel 3 Stainless steel 5 Fiberglass 7 PVC 10 Asbestos-cement
 2 Brass 4 Galvanized steel 6 Concrete tile 8 RMP (SR) 11 Other (specify) -
 12 None used (open hole)
 SCREEN OR PERFORATION OPENINGS ARE:
 1 Continuous slot 3 Mill slot 5 Gauzed wrapped 8 Saw cut 11 None (open hole)
 2 Louvered shutter 4 Key punched 6 Wire wrapped 9 Drilled holes
 7 Torch cut 10 Other (specify) -
 SCREEN-PERFORATED INTERVALS: From **65** ft. to **85** ft., From **105** ft. to **125** ft.
 From - ft. to - ft., From - ft. to - ft.
 GRAVEL PACK INTERVALS: From **7** ft. to **125** ft., From - ft. to - ft.
 From - ft. to - ft., From - ft. to - ft.

6 GROUT MATERIAL: 1 Neat cement 2 Cement grout 3 Bentonite 4 Other -
 Grout Intervals: *** From 3** ft. to **7** ft., From - ft. to - ft., From - ft. to - ft.
 What is the nearest source of possible contamination:
 1 Septic tank 4 Lateral lines 7 Pit privy 10 Livestock pens 14 Abandoned water well
 2 Sewer lines 5 Cess pool 8 Sewage lagoon 11 Fuel storage 15 Oil well/Gas well
 3 Watertight sewer lines 6 Seepage pit 9 Feedyard 12 Fertilizer storage 16 Other (specify below)
 13 Insecticide storage
 Direction from well? **N-NE** How many feet? **250'**

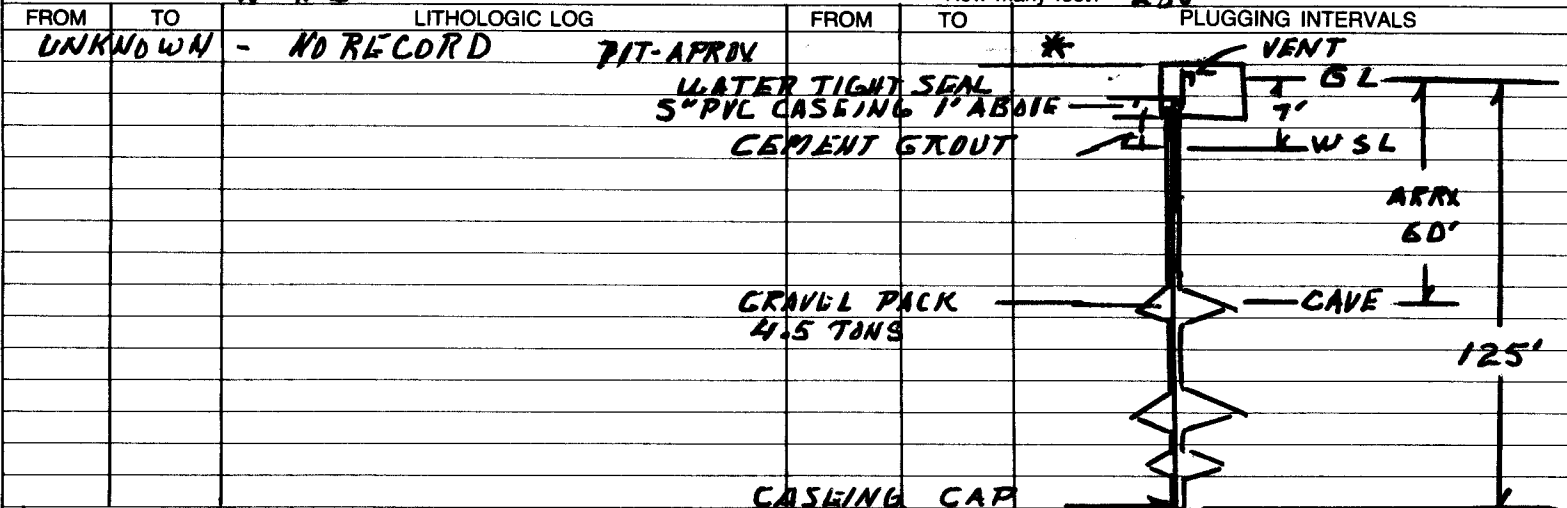

7 CONTRACTOR'S OR LANDOWNER'S CERTIFICATION: This water well was (1) constructed, (2) reconstructed, or (3) plugged under my jurisdiction and was completed on (mo/day/year) **09-15-89** and this record is true to the best of my knowledge and belief. Kansas Water Well Contractor's License No. **479** This Water Well Record was completed on (mo/day/yr) **09-15-89** under the business name of **EBBERTS DRILLING** by (signature) **Shogan**