


1 LOCATION OF WATER WELL: Fraction SE 1/4 SE 1/4 NW 1/4 Section Number 31 Township Number T 20 S Range Number R 8 E/W
 County: CHASE

Distance and direction from nearest town or city street address of well if located within city?
APPROX 3 M W - BAZZAR

2 WATER WELL OWNER: JOE BLOUNT
 RR#, St. Address, Box #: Box 187 COTTONWOOD FALL KS Board of Agriculture, Division of Water Resources
 City, State, ZIP Code: 66845 Application Number:

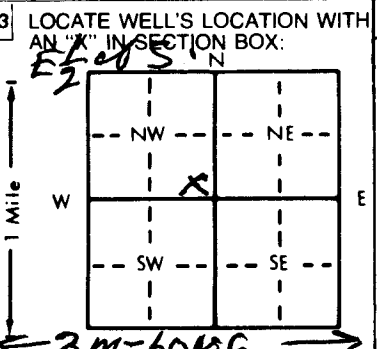

4 DEPTH OF COMPLETED WELL: 77 ft. ELEVATION:
 Depth(s) Groundwater Encountered 1. 34.5 ft. 2. ft. 3. ft.
 WELL'S STATIC WATER LEVEL: 17 ft. below land surface measured on mo/day/yr 02-13-2000
 Pump test data: Well water was ft. after hours pumping gpm
 Est. Yield: .83 gpm. Well water was ft. after hours pumping gpm
 Bore Hole Diameter: 7.25 in. to 77 ft., and in. to ft.
 WELL WATER TO BE USED AS:
 1 Domestic 3 Feedlot 6 Oil field water supply 9 Dewatering 12 Other (Specify below)
 2 Irrigation 4 Industrial 7 Lawn and garden only 10 Monitoring well
 Was a chemical/bacteriological sample submitted to Department? Yes No If yes, mo/day/yr sample was submitted
 Water Well Disinfected? Yes No

5 TYPE OF BLANK CASING USED:
 1 Steel 3 RMP (SR) 6 Asbestos-Cement 9 Other (specify below) Welded
 2 PVC 4 ABS 7 Fiberglass Threaded
 Blank casing diameter: 4.5 in. to 30 ft., Dia. in. to ft., Dia. in. to ft.
 Casing height above land surface: 24 in., weight SC40 lbs./ft. Wall thickness or gauge No.
 TYPE OF SCREEN OR PERFORATION MATERIAL:
 1 Steel 3 Stainless steel 5 Fiberglass 7 PVC 10 Asbestos-cement
 2 Brass 4 Galvanized steel 6 Concrete tile 9 ABS 12 None used (open hole)
 SCREEN OR PERFORATION OPENINGS ARE:
 1 Continuous slot 3 Mill slot 6 Wire wrapped 9 Drilled holes
 2 Louvered shutter 4 Key punched 7 Torch cut 10 Other (specify)
 SCREEN-PERFORATED INTERVALS: From 30 ft. to 60 ft., From 60 ft. to 77 ft.
 GRAVEL PACK INTERVALS: From 20 ft. to 77 ft., From ft. to ft.
KDHE-SAND-WCHITA

6 GROUT MATERIAL: 1 Neat cement 2 Cement grout 3 Bentonite 4 Other
 Grout intervals: From 0 ft. to 20 ft., From ft. to ft., From ft. to ft.
 What is the nearest source of possible contamination: NONE
 1 Septic tank 4 Lateral lines 7 Pit privy 10 Livestock pens 14 Abandoned water well
 2 Sewer lines 5 Cess pool 8 Sewage lagoon 11 Fuel storage 15 Oil well/Gas well
 3 Watertight sewer lines 6 Seepage pit 9 Feedyard 12 Fertilizer storage 16 Other (specify below)
 13 Insecticide storage

Direction from well? How many feet?

FROM	TO	LITHOLOGIC LOG	FROM	TO	PLUGGING INTERVALS
0	3	TOP			
3	9	Lime Clay etc			
9	13	SHALE			
13	19	LIME			
19	22	SHALE			
22	30	LIME			
30	34	SHALE			
34	34.5	Black shale			
34.5	35	Lime			
35	38	SHALE			
38	45	SHALE			
45	49	LIME			
49	51	SHALE			
51	56.5	LIME			
56.5	67	SHALE			
67	67.8	Lime TP			

7 CONTRACTOR'S OR LANDOWNER'S CERTIFICATION: This water well was (1) constructed, (2) reconstructed, or (3) plugged under my jurisdiction and was completed on (mo/day/year) 02-13-2000 and this record is true to the best of my knowledge and belief. Kansas Water Well Contractor's License No. 02-479 This Water Well Record was completed on (mo/day/yr) 02-13-2000 under the business name of EBBERTS DRILLING by (signature) Joe Blount

OFFICE USE ONLY

T

R

EW

SEC.

1/4

1/4

1/4