


1 LOCATION OF WATER WELL: Fraction SW 1/4 NE 1/4 SW 1/4 Section Number WY 2 of 31 Township Number T 20 S Range Number R 8 E  
 County: Chase

Distance and direction from nearest town or city street address of well if located within city?

2.5 mile West of BAZZAR

2 WATER WELL OWNER: Soe STOUT  
 RR#, St. Address, Box #: 2026 Canterbury Rd  
 City, State, ZIP Code: Emporia, Kansas 66801  
 Board of Agriculture, Division of Water Resources  
 Application Number:

3 LOCATE WELL'S LOCATION WITH AN "X" IN SECTION BOX:

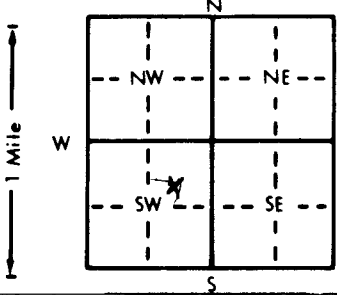

4 DEPTH OF COMPLETED WELL: 70 ft. ELEVATION:  
 Depth(s) Groundwater Encountered 1. 9 ft. 2. ft. 3. ft.  
 WELL'S STATIC WATER LEVEL 3 ft. below land surface measured on mo/day/yr May 4 98  
 Pump test data: Well water was ft. after hours pumping gpm  
 Est. Yield 21 gpm: Well water was ft. after hours pumping gpm  
 Bore Hole Diameter: 10 in. to 12 in. and 7 in. to 20 in.  
 WELL WATER TO BE USED AS:  
 1 Domestic  3 Feedlot  6 Oil field water supply  9 Dewatering  12 Other (Specify below)  
 2 Irrigation  4 Industrial  7 Lawn and garden only  10 Monitoring well  
 Was a chemical/bacteriological sample submitted to Department? Yes.....No.  If yes, mo/day/yr sample was submitted  
 Water Well Disinfected?  Yes  No

5 TYPE OF BLANK CASING USED:  
 1 Steel  3 RMP (SR)  6 Asbestos-Cement  9 Other (specify below) Welded.....  
 2 PVC  4 ABS  7 Fiberglass Threaded.....  
 Blank casing diameter 5 in. to 8 ft., Dia. in. to ft., Dia. in. to ft.  
 Casing height above land surface 18 in., weight lbs./ft. Wall thickness or gauge No. SDR-26  
 TYPE OF SCREEN OR PERFORATION MATERIAL:  
 1 Steel  3 Stainless steel  5 Fiberglass  7 PVC  10 Asbestos-cement  
 2 Brass  4 Galvanized steel  6 Concrete tile  9 ABS  12 None used (open hole)  
 SCREEN OR PERFORATION OPENINGS ARE:  
 1 Continuous slot  3 Mill slot  5 Gauzed wrapped  8 Saw cut  11 None (open hole)  
 2 Louvered shutter  4 Key punched  6 Wire wrapped  9 Drilled holes  
 7 Torch cut  10 Other (specify)  
 SCREEN-PERFORATED INTERVALS: From 8 ft. to 70 ft. From ft. to ft. From ft. to ft.  
 GRAVEL PACK INTERVALS: From NONE ft. to ft. From ft. to ft. From ft. to ft.

6 GROUT MATERIAL:  1 Neat cement  2 Cement grout  3 Bentonite  4 Other  
 Grout Intervals: From 3 ft. to 7 ft. From ft. to ft. From ft. to ft.  
 What is the nearest source of possible contamination:  
 1 Septic tank  4 Lateral lines  7 Pit privy  10 Livestock pens  14 Abandoned water well  
 2 Sewer lines  5 Cess pool  8 Sewage lagoon  11 Fuel storage  15 Oil well/Gas well  
 3 Watertight sewer lines  6 Seepage pit  9 Feedyard  12 Fertilizer storage  16 Other (specify below) Creek  
 13 Insecticide storage  
 Direction from well? West How many feet? 70

FROM	TO	LITHOLOGIC LOG	FROM	TO	PLUGGING INTERVALS
0	1	Gravel			
1	12	LIME Frac TAN			
12	15	Shale Gray			
15	20	LIME Gray			
20	23	Shale Lite Gray			
23	29	LIME-Flint			
29	35	Shale Gray			
35	39	LIME Gray			
39	41	Shale Gray			
41	57	LIME & Shale Lite Gray			
57	61	Shale Lite Gray			
61	64	LIME Lite Gray			
64	70	Shale Lite Gray			

7 CONTRACTOR'S OR LANDOWNER'S CERTIFICATION: This water well was  (1) constructed,  (2) reconstructed, or  (3) plugged under my jurisdiction and was completed on (mo/day/year) May 4 98 and this record is true to the best of my knowledge and belief. Kansas Water Well Contractor's License No. 218 This Water Well Record was completed on (mo/day/yr) May 7-98 under the business name of ZINN Water Well Dnlg. by signature