


1 LOCATION OF WATER WELL: County: **CHASE** Fraction: **NW 1/4 NW 1/4 NW 1/4** Section Number: **4** Township Number: **T 20 S** Range Number: **R 8 E**

Distance and direction from nearest town or city street address of well if located within city?
APPROX 1.25 MS ON HW 177 FROM 8TH ST. COTTONWOOD FALLS - 1/4 M EAST -

2 WATER WELL OWNER: **BILL FILLMORE**
 RR#, St. Address, Box #: **ROUTE 1 BOX 93**
 City, State, ZIP Code: **COTTONWOOD FALLS KS 66845**
 Board of Agriculture, Division of Water Resources
 Application Number:

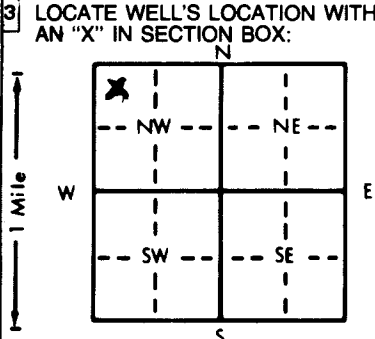

4 DEPTH OF COMPLETED WELL: **64** ... **30** ... ft. ELEVATION: **-**
 Depth(s) Groundwater Encountered 1. **UNKNOWN** ... ft. 2. ... ft. 3. ... ft.
 WELL'S STATIC WATER LEVEL ... **15** ... ft. below land surface measured on mo/day/yr **02-01-89**
 Pump test data: Well water was ... ft. after ... hours pumping ... gpm
 Est. Yield ... **5** ... gpm: Well water was ... ft. after ... hours pumping ... gpm
 Bore Hole Diameter: **UNKNOWN TO 24** ... ft., and ... **6** ... in. to **30** ... ft.
 WELL WATER TO BE USED AS:
 5 Public water supply 8 Air conditioning 11 Injection well
 1 Domestic 3 Feedlot 6 Oil field water supply 9 Dewatering 12 Other (Specify below)
 2 Irrigation 4 Industrial 7 Lawn and garden only 10 Monitoring well
 Was a chemical/bacteriological sample submitted to Department? Yes ... No **X** ...; If yes, mo/day/yr sample was submitted
 Water Well Disinfected? Yes **X** No

5 TYPE OF BLANK CASING USED:
 1 Steel 3 RMP (SR) 5 Wrought iron 8 Concrete tile CASING JOINTS: Glued ... Clamped ...
 2 PVC 4 ABS 7 Fiberglass **NA** 9 Other (specify below) Welded ...
 Threaded ...
 Blank casing diameter ... **7** ... in. to **APPROX 24** ... ft., Dia ... in. to ... ft., Dia ... in. to ... ft.
 Casing height above land surface ... **18** ... in., weight ... **UNKNOWN** ... lbs./ft. Wall thickness or gauge No. ...
 TYPE OF SCREEN OR PERFORATION MATERIAL:
 1 Steel 3 Stainless steel 5 Fiberglass 8 RMP (SR) 10 Asbestos-cement
 2 Brass 4 Galvanized steel 6 Concrete tile 9 ABS 12 None used (open hole)
 SCREEN OR PERFORATION OPENINGS ARE:
 1 Continuous slot 3 Mill slot 5 Gauzed wrapped 8 Saw cut 11 None (open hole)
 2 Louvered shutter 4 Key punched 7 Torch cut 9 Drilled holes 10 Other (specify) ...
 SCREEN-PERFORATED INTERVALS: From **UNKNOWN** ... ft. to ... ft., From ... ft. to ... ft.
 GRAVEL PACK INTERVALS: From **UNKNOWN** ... ft. to ... ft., From ... ft. to ... ft.

6 GROUT MATERIAL: 1 Neat cement 2 Cement grout 3 Bentonite 4 Other **UNKNOWN**
 Grout intervals: From ... ft. to ... ft., From ... ft. to ... ft., From ... ft. to ... ft.
 What is the nearest source of possible contamination:
 1 Septic tank 4 Lateral lines 7 Pit privy 10 Livestock pens 14 Abandoned water well
 2 Sewer lines 5 Cess pool 8 Sewage lagoon 11 Fuel storage 15 Oil well/Gas well
 3 Watertight sewer lines 6 Seepage pit 9 Feedyard 12 Fertilizer storage 16 Other (specify below)
 13 Insecticide storage

Direction from well? How many feet?

FROM	TO	LITHOLOGIC LOG	FROM	TO	PLUGGING INTERVALS
0	24	UNKNOWN			
24	26	LIME			
26	30	SHALE LT GREY			
30		OLD WELL - WORK OVER CLEAN OUT DEEPEN + DISINFECTED			

7 CONTRACTOR'S OR LANDOWNER'S CERTIFICATION: This water well was (1) constructed, (2) reconstructed, or (3) plugged under my jurisdiction and was completed on (mo/day/year) **02-01-89** and this record is true to the best of my knowledge and belief. Kansas Water Well Contractor's License No. **479** This Water Well Record was completed on (mo/day/yr) **02-02-89** under the business name of **EBBERTS DRILLING** by (signature) *Arayan Ebberts*

OFFICE USE ONLY
T
R
EW
SEC.
1/4
1/4
1/4