


1 LOCATION OF WATER WELL: Fraction SW 1/4 SW 1/4 NE 1/4 Section Number 16 Township Number T 20 S Range Number R 8 E
 County: Chase

Distance and direction from nearest town or city street address of well if located within city?
1/2 East 3/4 South Cottonwood Falls Ks.

2 WATER WELL OWNER: William F Filmore
 RR#, St. Address, Box #: RT1 - Bx66 Board of Agriculture, Division of Water Resources
 City, State, ZIP Code: COTTONWOOD FALLS KS 66845 Application Number: NA

3 LOCATE WELL'S LOCATION WITH AN "X" IN SECTION BOX:

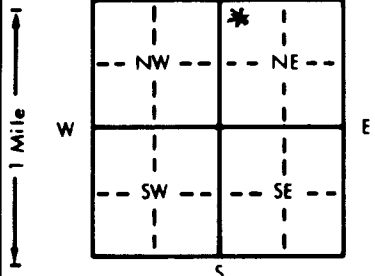

4 DEPTH OF COMPLETED WELL: 97' ft. ELEVATION: _____ ft.

Depth(s) Groundwater Encountered 1. 44-47 ft. 2. _____ ft. 3. _____ ft.

WELL'S STATIC WATER LEVEL 19' ft. below land surface measured on mo/day/yr 8-26-94

Pump test data: Well water was _____ ft. after _____ hours pumping _____ gpm
 Est. Yield 0.4 gpm; Well water was _____ ft. after _____ hours pumping _____ gpm

Bore Hole Diameter: 12 in. to 97 ft., and _____ in. to _____ ft.

WELL WATER TO BE USED AS:
 5 Public water supply 8 Air conditioning 11 Injection well
 1 Domestic 3 Feedlot 6 Oil field water supply 9 Dewatering 12 Other (Specify below)
 2 Irrigation 4 Industrial 7 Lawn and garden only 10 Monitoring well

Was a chemical/bacteriological sample submitted to Department? Yes _____ No X _____; If yes, mo/day/yr sample was submitted _____
 Water Well Disinfected? Yes X No _____

5 TYPE OF BLANK CASING USED:
 1 Steel 3 RMP (SR) 5 Wrought iron 8 Concrete tile CASING JOINTS: Glued X Clamped _____
 2 PVC 4 ABS 6 Asbestos-Cement 9 Other (specify below) Welded _____
 7 Fiberglass Threaded _____

Blank casing diameter 6 in. to 20 ft., Dia. 10" in. to 96 ft., Dia. _____ in. to _____ ft.
 Casing height above land surface 24 in., weight 160 lbs./ft. Wall thickness or gauge No. 160

TYPE OF SCREEN OR PERFORATION MATERIAL:
 1 Steel 3 Stainless steel 7 PVC 10 Asbestos-cement
 2 Brass 4 Galvanized steel 6 Concrete tile 9 ABS 11 Other (specify) _____
 12 None used (open hole)

SCREEN OR PERFORATION OPENINGS ARE:
 1 Continuous slot 3 Mill slot 5 Gauzed wrapped 8 Saw cut 11 None (open hole)
 2 Louvered shutter 4 Key punched 6 Wire wrapped 9 Drilled holes
 7 Torch cut 10 Other (specify) _____

SCREEN-PERFORATED INTERVALS: From 22' ft. to 94' ft., From _____ ft. to _____ ft.
 From _____ ft. to _____ ft., From _____ ft. to _____ ft.
 GRAVEL PACK INTERVALS: From _____ ft. to _____ ft., From _____ ft. to _____ ft.
 From _____ ft. to _____ ft., From _____ ft. to _____ ft.

6 GROUT MATERIAL: 1 Neat cement 2 Cement grout 3 Bentonite 4 Other _____
 Grout intervals: From 20 ft. to 10 ft., From 10 ft. to 1 ft., From _____ ft. to _____ ft.

What is the nearest source of possible contamination:
 1 Septic tank 4 Lateral lines 7 Pit privy 10 Livestock pens 14 Abandoned water well
 2 Sewer lines 5 Cess pool 8 Sewage lagoon 11 Fuel storage 15 Oil well/Gas well
 3 Watertight sewer lines 6 Seepage pit 9 Feedyard 12 Fertilizer storage 16 Other (specify below)
 13 Insecticide storage

Direction from well? N-E Down slope How many feet? 125

FROM	TO	LITHOLOGIC LOG	FROM	TO	PLUGGING INTERVALS
0	4	CL Brn	72	85	Silt Stone Gray med Dense
4	10	CL Sh yellow	85	97	Sh w Box work Varigated
10	14	Cal Sh Gray, Blue			Color
14	20	" "			
20	27	" "			Well Field tested Nitrate 18 ppm
27	30.5	Lime Gray			Sulfate 250 ppm
30.5	35	Cal Sh. DK			
35	44	Sh DK Silty			
44	47	Boxwork			
47	65	Brkn Lime + Sh			
65	70	Sh w Gyp			
70	72	" "			

7 CONTRACTOR'S OR LANDOWNER'S CERTIFICATION: This water well was constructed, (2) reconstructed, or (3) plugged under my jurisdiction and was completed on (mo/day/year) 9-7-94 and this record is true to the best of my knowledge and belief. Kansas Water Well Contractor's License No. 203 This Water Well Record was completed on (mo/day/yr) 9-30-94 under the business name of McNee Drilling & Metals by (signature) J.C. McNee

OFFICE USE ONLY
T
R
EW
SEC.
1/4
1/4
1/4