


1 LOCATION OF WATER WELL: County: Chase Fraction: SW 1/4 SW 1/4 NE 1/4 Section Number: 16 Township Number: T 20 S Range Number: R 8 E

Distance and direction from nearest town or city street address of well if located within city?
1/2 - East 3/4 South

2 WATER WELL OWNER: William F Filmore
RR#, St. Address, Box #: RT1 BOX 66 Board of Agriculture, Division of Water Resources
City, State, ZIP Code: Cottonwood Falls Ks. 66845 Application Number: NA

3 LOCATE WELL'S LOCATION WITH AN "X" IN SECTION BOX:

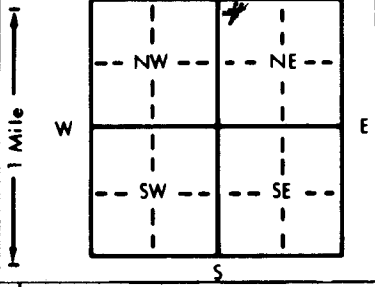

4 DEPTH OF COMPLETED WELL: 40 ft. ELEVATION: _____

Depth(s) Groundwater Encountered 1. _____ ft. 2. _____ ft. 3. _____ ft.
WELL'S STATIC WATER LEVEL: 20 ft. below land surface measured on mo/day/yr
Pump test data: Well water was _____ ft. after _____ hours pumping _____ gpm
Est. Yield _____ gpm: Well water was _____ ft. after _____ hours pumping _____ gpm
Bore Hole Diameter: _____ in. to _____ ft., and _____ in. to _____ ft.
WELL WATER TO BE USED AS:
 1 Domestic 3 Feedlot 6 Oil field water supply 9 Dewatering 12 Other (Specify below)
 2 Irrigation 4 Industrial 7 Lawn and garden only 10 Monitoring well
 Was a chemical/bacteriological sample submitted to Department? Yes _____ No X _____; If yes, mo/day/yr sample was submitted _____
 Water Well Disinfected? Yes X No _____

5 TYPE OF BLANK CASING USED:
 1 Steel 3 RMP (SR) 5 Wrought iron 8 Concrete tile CASING JOINTS: Glued _____ Clamped _____
 2 PVC 4 ABS 6 Asbestos-Cement 9 Other (specify below) Tin Welded _____
 7 Fiberglass Threaded _____

Blank casing diameter _____ in. to _____ ft., Dia. _____ in. to _____ ft., Dia. _____ in. to _____ ft.
 Casing height above land surface _____ in., weight _____ lbs./ft. Wall thickness or gauge No. _____

TYPE OF SCREEN OR PERFORATION MATERIAL:
 1 Steel 3 Stainless steel 5 Fiberglass 7 PVC 8 RMP (SR) 9 ABS 10 Asbestos-cement
 2 Brass 4 Galvanized steel 6 Concrete tile 11 Other (specify) NA
 12 None used (open hole)

SCREEN OR PERFORATION OPENINGS ARE:
 1 Continuous slot 3 Mill slot 5 Gauzed wrapped 8 Saw cut 11 None (open hole)
 2 Louvered shutter 4 Key punched 6 Wire wrapped 9 Drilled holes
 7 Torch cut 10 Other (specify) NA

SCREEN-PERFORATED INTERVALS: From NA ft. to NA ft., From _____ ft. to _____ ft.
 From _____ ft. to _____ ft., From _____ ft. to _____ ft.
 GRAVEL PACK INTERVALS: From _____ ft. to _____ ft., From _____ ft. to _____ ft.
 From _____ ft. to _____ ft., From _____ ft. to _____ ft.

6 GROUT MATERIAL: 1 Neat cement 2 Cement grout 3 Bentonite 4 Other _____
 Grout intervals: From 6 ft. to 3 ft., From _____ ft. to _____ ft., From _____ ft. to _____ ft.

What is the nearest source of possible contamination:
 1 Septic tank 4 Lateral lines 7 Pit privy 10 Livestock pens 14 Abandoned water well
 2 Sewer lines 5 Cess pool 8 Sewage lagoon 11 Fuel storage 15 Oil well/Gas well
 3 Watertight sewer lines 6 Seepage pit 9 Feedyard 12 Fertilizer storage 16 Other (specify below)
 13 Insecticide storage

Direction from well? _____ How many feet? _____

FROM	TO	LITHOLOGIC LOG	FROM	TO	PLUGGING INTERVALS
		Pulled All old Tin casing Down to 40' Hole Had so much Iron. we could not get down to TD. Filled with Gravel to 30' Dumped 3 sacks portland cement. In Lime 27-30 Filled to 6 with clay, Dumped 2 Bags Ewino plug. Filled to surface with clay.			
			40	20	Gravel
			20	6	Clay
			6	3	Bentonite
			3	0	Clay

7 CONTRACTOR'S OR LANDOWNER'S CERTIFICATION: This water well was (1) constructed, (2) reconstructed, or (3) plugged under my jurisdiction and was completed on (mo/day/year) 9-7-94 and this record is true to the best of my knowledge and belief. Kansas Water Well Contractor's License No. 203 This Water Well Record was completed on (mo/day/yr) 9-30-94 under the business name of McNee Drilling by (signature) JC McNee