


1 LOCATION OF WATER WELL: County: Marion Fraction: 1/2 1/4 1/2 1/4 Section Number: 7 Township Number: T 21 S Range Number: R 1 EW

Distance and direction from nearest town or city street address of well if located within city?  
2 W Goessel

2 WATER WELL OWNER: Ron Derksen  
 RR#, St. Address, Box #: 200 W Commercial  
 City, State, ZIP Code: Goessel, KS, 67053  
 Board of Agriculture, Division of Water Resources  
 Application Number:

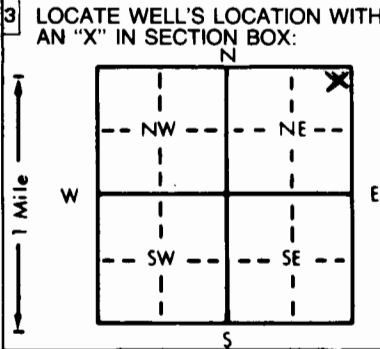

4 DEPTH OF COMPLETED WELL: 125 ft. ELEVATION:  
 Depth(s) Groundwater Encountered 1. 115 ft. 2. ft. 3. ft.  
 WELL'S STATIC WATER LEVEL: 13 ft. below land surface measured on mo/day/yr 9-11-95  
 Pump test data: Well water was ft. after hours pumping gpm  
 Est. Yield: 20 gpm Well water was ft. after hours pumping gpm  
 Bore Hole Diameter: 9 in. to 33 ft., and 7 1/2 in. to 125 ft.  
 WELL WATER TO BE USED AS:  
 1 Domestic 3 Feedlot 6 Oil field water supply 9 Dewatering 12 Other (Specify below)  
 2 Irrigation 4 Industrial 7 Lawn and garden only 10 Monitoring well  
 Was a chemical/bacteriological sample submitted to Department? Yes No X; If yes, mo/day/yr sample was submitted  
 Water Well Disinfected? Yes X No

5 TYPE OF BLANK CASING USED:  
 1 Steel 3 RMP (SR) 5 Wrought iron 8 Concrete tile CASING JOINTS: Glued X Clamped  
 2 PVC 4 ABS 6 Asbestos-Cement 9 Other (specify below) Welded  
 7 Fiberglass Threaded  
 Blank casing diameter: 5 in. to 105 ft. Dia. in. to ft. Dia. in. to ft.  
 Casing height above land surface: 12 in. weight Class 160 lbs./ft. Wall thickness or gauge No. 214  
 TYPE OF SCREEN OR PERFORATION MATERIAL:  
 1 Steel 3 Stainless steel 5 Fiberglass 7 PVC 10 Asbestos-cement  
 2 Brass 4 Galvanized steel 6 Concrete tile 8 RMP (SR) 11 Other (specify)  
 12 None used (open hole)  
 SCREEN OR PERFORATION OPENINGS ARE:  
 1 Continuous slot 3 Mill slot 5 Gauzed wrapped 8 Saw cut 11 None (open hole)  
 2 Louvered shutter 4 Key punched 6 Wire wrapped 9 Drilled holes  
 7 Torch cut 10 Other (specify)  
 SCREEN-PERFORATED INTERVALS: From 105 ft. to 125 ft. From ft. to ft.  
 GRAVEL PACK INTERVALS: From ft. to ft. From ft. to ft.

6 GROUT MATERIAL: 1 Neat cement 2 Cement grout 3 Bentonite 4 Other  
 Grout intervals: From 0 ft. to 20 ft. From ft. to ft. From ft. to ft.  
 What is the nearest source of possible contamination:  
 1 Septic tank 4 Lateral lines 7 Pit privy 10 Livestock pens 14 Abandoned water well  
 2 Sewer lines 5 Cess pool 8 Sewage lagoon 11 Fuel storage 15 Oil well/Gas well  
 3 Watertight sewer lines 6 Seepage pit 9 Feedyard 12 Fertilizer storage 16 Other (specify below)  
 13 Insecticide storage  
 Direction from well? SW How many feet? 30 +

FROM	TO	LITHOLOGIC LOG	FROM	TO	PLUGGING INTERVALS
0	9	Clay			
9	17	<del>Clay</del> fine sand			
17	<del>19</del>	<del>Yellow</del> clay			
<del>19</del>	20	Sand			
20	105	Blue-Gray Shale			
105	106	Water			
106	125	Gray Shale			

7 CONTRACTOR'S OR LANDOWNER'S CERTIFICATION: This water well was (1) constructed, (2) reconstructed, or (3) plugged under my jurisdiction and was completed on (mo/day/year) 9-11-95 and this record is true to the best of my knowledge and belief. Kansas Water Well Contractor's License No. 700 This Water Well Record was completed on (mo/day/yr) 9-13-95 under the business name of Backhus Drilling by (signature) Paul Backhus