


1 LOCATION OF WATER WELL: County: Marion Fraction: SE 1/4 SE 1/4 SE 1/4 Section Number: 8 Township Number: T 21 S Range Number: R 1 EW

Distance and direction from nearest town or city street address of well if located within city? N of Newton on 15 to govt 1 mi E and 500 ft N on W S

2 WATER WELL OWNER: Monty Fry R2 Marion Kansas Board of Agriculture, Division of Water Resources
 RR#, St. Address, Box #: 67114 Application Number:

3 LOCATE WELL'S LOCATION WITH AN "X" IN SECTION BOX:

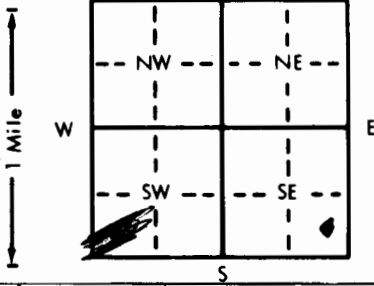

4 DEPTH OF COMPLETED WELL: 117 ft. ELEVATION:

Depth(s) Groundwater Encountered 1. 30 ft. 2. 80 ft. 3. 15 ft.
 WELL'S STATIC WATER LEVEL 30 ft. below land surface measured on mo/day/yr 8/3/1986
 Pump test data: Well water was 80 ft. after 1 hours pumping 15 gpm
 Est. Yield 15 gpm: Well water was 80 ft. after 1 hours pumping 15 gpm
 Bore Hole Diameter 8 in. to 117 ft., and 8 in. to 117 ft.
 WELL WATER TO BE USED AS:
 1 Domestic 3 Feedlot 6 Oil field water supply 9 Dewatering 12 Other (Specify below)
 2 Irrigation 4 Industrial 7 Lawn and garden only 10 Observation well
 Was a chemical/bacteriological sample submitted to Department? Yes X No X; If yes, mo/day/yr sample was submitted
 Water Well Disinfected? Yes X No X

5 TYPE OF BLANK CASING USED:
 1 Steel 3 RMP (SR) 5 Wrought iron 8 Concrete tile CASING JOINTS: Glued X Clamped X
 2 PVC 4 ABS 6 Asbestos-Cement 9 Other (specify below) S.D.R 26 Welded X
 7 Fiberglass S.D.R 26 Threaded X

Blank casing diameter 5 in. to 117 ft., Dia. 5 in. to 117 ft., Dia. 5 in. to 117 ft., Dia. 5 in. to 117 ft.
 Casing height above land surface 18 in., weight 200 lbs./ft. Wall thickness or gauge No. 3/16

TYPE OF SCREEN OR PERFORATION MATERIAL:
 1 Steel 3 Stainless steel 5 Fiberglass 7 PVC 10 Asbestos-cement
 2 Brass 4 Galvanized steel 6 Concrete tile 8 RMP (SR) 11 Other (specify) S.D.R 26
 9 ABS 12 None used (open hole)

SCREEN OR PERFORATION OPENINGS ARE:
 1 Continuous slot 3 Mill slot 5 Gauzed wrapped 8 Saw cut 11 None (open hole)
 2 Louvered shutter 4 Key punched 6 Wire wrapped 9 Drilled holes
 7 Torch cut 10 Other (specify) 89

SCREEN-PERFORATED INTERVALS: From 29 ft. to 69 ft., From 89 ft. to 109 ft.
 From 29 ft. to 69 ft., From 89 ft. to 109 ft.
 GRAVEL PACK INTERVALS: From 20 ft. to 117 ft., From 20 ft. to 117 ft.
 From 20 ft. to 117 ft., From 20 ft. to 117 ft.

6 GROUT MATERIAL: 1 Neat cement 2 Cement grout 3 Bentonite 4 Other
 Grout Intervals: From top ft. to 20 ft., From 20 ft. to 117 ft., From 117 ft. to 117 ft.

What is the nearest source of possible contamination:
 1 Septic tank 4 Lateral lines 7 Pit privy 10 Livestock pens 14 Abandoned water well
 2 Sewer lines 5 Cess pool 8 Sewage lagoon 11 Fuel storage 15 Oil well/Gas well
 3 Watertight sewer lines 6 Seepage pit 9 Feedyard 12 Fertilizer storage 16 Other (specify below)
 13 Insecticide storage
 Direction from well? NW How many feet? 125

FROM	TO	LITHOLOGIC LOG	FROM	TO	LITHOLOGIC LOG
<u>top</u>	<u>3</u>	<u>cap soil</u>			
<u>3</u>	<u>30</u>	<u>Blue Shale</u>			
<u>30</u>	<u>60</u>	<u>Rocking Blue Shale</u>			
<u>60</u>	<u>102</u>	<u>Blue clay</u>			
<u>102</u>	<u>110</u>	<u>Blue shale</u>			
<u>110</u>	<u>112</u>	<u>gravel type shale</u>			
<u>112</u>	<u>117</u>	<u>Blue shale</u>			

7 CONTRACTOR'S OR LANDOWNER'S CERTIFICATION: This water well was 1 constructed, (2) reconstructed, or (3) plugged under my jurisdiction and was completed on (mo/day/year) Apr 5 1986 and this record is true to the best of my knowledge and belief. Kansas Water Well Contractor's License No. 221 This Water Well Record was completed on (mo/day/yr) Dec 15 1986 under the business name of Frank Budale by (signature) Frank Budale

INSTRUCTIONS: Use typewriter or ball point pen, PLEASE PRESS FIRMLY and PRINT clearly. Please fill in blanks, underline or circle the correct answers. Send top three copies to Kansas Department of Health and Environment, Division of Environment, Environmental Geology Section, Topeka, KS 66620. Send one to WATER WELL OWNER and retain one for your records.