


1 LOCATION OF WATER WELL: Fraction Se 1/4 Sw 1/4 Se 1/4 Section Number 32 Township Number T 21 S Range Number R 1 E  
 County: Marion

Distance and direction from nearest town or city street address of well if located within city?  
5 S 1/4 W Goessel

2 WATER WELL OWNER: Mike Goerzen  
 RR#, St. Address, Box #: RR 2 Box 51  
 City, State, ZIP Code: Newton, KS. 67114  
 Board of Agriculture, Division of Water Resources  
 Application Number:

3 LOCATE WELL'S LOCATION WITH AN "X" IN SECTION BOX:

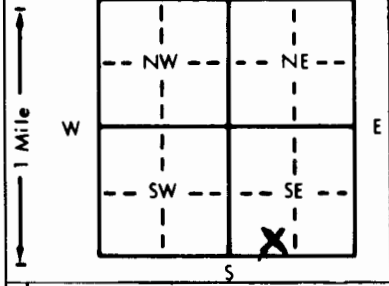

4 DEPTH OF COMPLETED WELL: 52 ft. ELEVATION: ..... ft.

Depth(s) Groundwater Encountered 1. 15 ft. 2. .... ft. 3. .... ft.  
 WELL'S STATIC WATER LEVEL 10 ft. below land surface measured on mo/day/yr 5-13-92  
 Pump test data: Well water was ..... ft. after ..... hours pumping ..... gpm  
 Est. Yield 5-10 gpm; Well water was ..... ft. after ..... hours pumping ..... gpm  
 Bore Hole Diameter: 9 in. to 52 ft., and ..... in. to ..... ft.

WELL WATER TO BE USED AS:  
 Domestic 3 Feedlot 6 Oil field water supply 9 Dewatering 12 Other (Specify below)  
 2 Irrigation 4 Industrial 7 Lawn and garden only 10 Monitoring well  
 Was a chemical/bacteriological sample submitted to Department? Yes.....No.....; If yes, mo/day/yr sample was submitted  
 Water Well Disinfected? Yes  No

5 TYPE OF BLANK CASING USED:  
 1 Steel 3 RMP (SR) 5 Wrought iron 8 Concrete tile CASING JOINTS: Glued  Clamped .....  
 2 PVC 4 ABS 6 Asbestos-Cement 9 Other (specify below) Welded .....  
 7 Fiberglass Threaded .....

Blank casing diameter 5 in. to 15 ft., Dia. 5 in. to 52 ft., Dia. .... in. to ..... ft.  
 Casing height above land surface 12 in., weight Class 160 lbs./ft. Wall thickness or gauge No. 214

TYPE OF SCREEN OR PERFORATION MATERIAL:  
 1 Steel 3 Stainless steel 5 Fiberglass 8 RMP (SR) 10 Asbestos-cement  
 2 Brass 4 Galvanized steel 6 Concrete tile 9 ABS 11 Other (specify) .....  
 12 None used (open hole)

SCREEN OR PERFORATION OPENINGS ARE:  
 1 Continuous slot 3 Mill slot 5 Gauzed wrapped 8 Saw cut 11 None (open hole)  
 2 Louvered shutter 4 Key punched 6 Wire wrapped 9 Drilled holes  
 7 Torch cut 10 Other (specify) .....

SCREEN-PERFORATED INTERVALS: From 15 ft. to 40 ft., From ..... ft. to ..... ft.  
 From ..... ft. to ..... ft., From ..... ft. to ..... ft.  
 GRAVEL PACK INTERVALS: From 14 ft. to 52 ft., From ..... ft. to ..... ft.  
 From ..... ft. to ..... ft., From ..... ft. to ..... ft.

6 GROUT MATERIAL: 1 Neat cement 2 Cement grout 3 Bentonite 4 Other .....  
 Grout Intervals: From 0 ft. to 14 ft., From ..... ft. to ..... ft., From ..... ft. to ..... ft.

What is the nearest source of possible contamination:  
 1 Septic tank 4 Lateral lines 7 Pit privy 10 Livestock pens 14 Abandoned water well  
 2 Sewer lines 5 Cess pool 8 Sewage lagoon 11 Fuel storage 15 Oil well/Gas well  
 3 Watertight sewer lines 6 Seepage pit 9 Feedyard 12 Fertilizer storage 16 Other (specify below)  
 13 Insecticide storage  
 Direction from well? W How many feet? 75

FROM	TO	LITHOLOGIC LOG	FROM	TO	PLUGGING INTERVALS
<u>0</u>	<u>14</u>	<u>Clay</u>			
<u>14</u>	<u>19</u>	<u>Sand</u>			
<u>19</u>	<u>52</u>	<u>Blue + Red Shale</u>			

7 CONTRACTOR'S OR LANDOWNER'S CERTIFICATION: This water well was (1) constructed, (2) reconstructed, or (3) plugged under my jurisdiction and was completed on (mo/day/year) 5-13-92 and this record is true to the best of my knowledge and belief. Kansas Water Well Contractor's License No. 127 This Water Well Record was completed on (mo/day/yr) 5-13-92 under the business name of Backhus Drilling by (signature) Paul H. Backhus