USE TYPEWRITER OR BALL POINT PEN-PRESS FIRMLY, PRINT CLEARLY.

WATER WELL RECORD
KSA 82a-1201-1215

Kansas Department of Health and Environment-Division of Environment
(Water well Contractors)
Topeka, Kansas 66620

1. Location of well:	County	Fraction	Section number	Township number	Range number
	MARION	SW 1/4 SW 1/4 SE 1/4	5	T 21 S	R 1 E/W

2. Distance and direction from nearest town or city:

Street address of well location if in city: 312 MARION

3. Owner of well: MEINO HEIBERT
R.R. or street: 312 MARION ST
City, state, zip code: GOESSEL KS 67053

4. Locate with "X" in section below: Sketch map: ALLEY

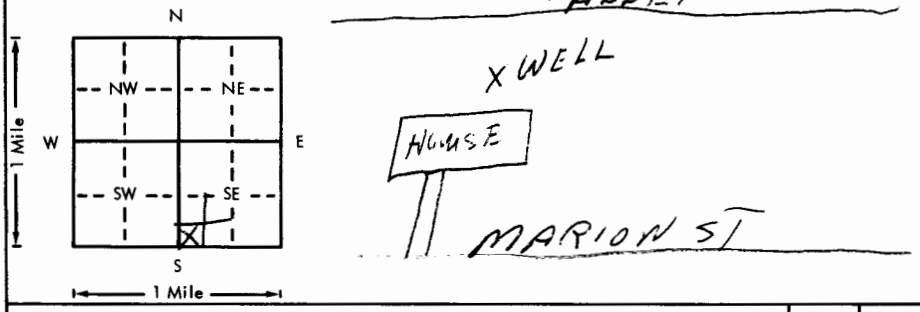

6. Bore hole dia. 20 in. Completion date 8-20-76
Well depth 40 ft.

7. __ Cable tool X Rotary __ Driven __ Dug
__ Hollow rod __ Jetted __ Bored __ Reverse rotary

8. Use: __ Domestic __ Public supply __ Industry
__ Irrigation __ Air conditioning __ Stock
X Lawn __ Oil field water __ Other

9. Casing: Material PLT Height: Above or below
Threaded ___ Welded ___ Surface 18 in.
RMP X PVC ___ Weight 1.50 lbs./ft.
Dia. 5 in. to 40 ft. depth Wall Thickness: inches or
Dia. ___ in. to ___ ft. depth gage No. -200

10. Screen: Manufacturer's name J&L
Type RMP Dia. 5
Slot/gauze .06 Length 30
Set between 10 ft. and 40 ft.
___ ft. and ___ ft.
Gravel pack? YES Size range of material 1/8

11. Static water level:
8 ft. below land surface Date 8-20-76 mo./day/yr.

12. Pumping level below land surfaces:
20 ft. after 1 hrs. pumping 12 g.p.m.
___ ft. after ___ hrs. pumping ___ g.p.m.
Estimated maximum yield 12 g.p.m.

13. Water sample submitted: mo./day/yr.
__ Yes X No Date

14. Well head completion:
__ Pitless adapter 18 Inches above grade

15. Well grouted? YES
With: X Neat cement __ Bentonite __ Concrete
Depth: From 0 ft. to 10 ft.

16. Nearest source of possible contamination: CITY
ft. 30 Direction N Type Sewer
Well disinfected upon completion? X Yes __ No

17. Pump: X Not installed
Manufacturer's name
Model number HP Volts
Length of drop pipe ft. capacity g.p.m.
Type:
__ Submersible __ Turbine
__ Jet __ Reciprocating
__ Centrifugal __ Other

5. Type and color of material

	From	To
Top Soil	0	3
Clay Red	3	8
Sand Fine	8	10
Sand Fine to Coarse	10	25
Limestone Rock	25	30
Shale Black	30	40

(Use a second sheet if needed)

18. Elevation:

Topography:
__ Hill
__ Slope
X Upland
__ Valley

19. Remarks:
~~Mr. Heibert will Run 4" X 4" Cut Slab around Well~~

20. Water well contractor's certification:
This well was drilled under my jurisdiction and this report is true to the best of my knowledge and belief.
D&R Well Service 211
Business name License No.
Address 428 W 3 Rd NEWTON KS
Signed W. Williams Date 9-6-76
Authorized representative

T 21 R 1 E/W Sec 5 1/4 1/4 1/4 SW SE

Forward the white, blue and pink copies to the Department of Health and Environment

Form WWC-5

M1-1023