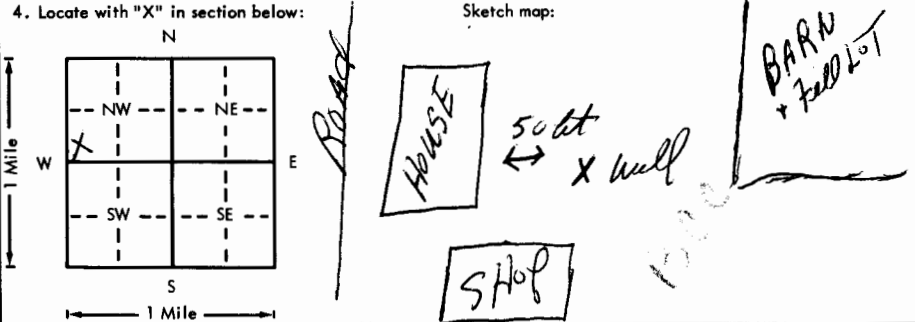


USE TYPEWRITER OR BALL POINT PEN-PRESS FIRMLY, PRINT CLEARLY.

WATER WELL RECORD
KSA 82a-1201-1215

Kansas Department of Health and Environment-Division of Environment
(Water well Contractors)
Topeka, Kansas 66620

1. Location of well:	County MARION	Fraction SW 1/4 SW 1/4 NW 1/4	Section number 22	Township number T 21 S R 1	Range number E 11
2. Distance and direction from nearest town or city: Street address of well location if in city:			3. Owner of well: R.R. or street: City, state, zip code:		
4. Locate with "X" in section below: 			6. Bore hole dia. 10 in. Completion date Well depth 44 ft. 8-28-76		
5. Type and color of material			7. Cable tool <input checked="" type="checkbox"/> Rotary <input type="checkbox"/> Driven <input type="checkbox"/> Dug <input type="checkbox"/> Hollow rod <input type="checkbox"/> Jetted <input type="checkbox"/> Bored <input type="checkbox"/> Reverse rotary		
			8. Use: <input checked="" type="checkbox"/> Domestic <input type="checkbox"/> Public supply <input type="checkbox"/> Industry <input type="checkbox"/> Irrigation <input type="checkbox"/> Air conditioning <input type="checkbox"/> Stock <input type="checkbox"/> Lawn <input type="checkbox"/> Oil field water <input type="checkbox"/> Other		
From To			9. Casing: Material PITS Height: Above or below Threaded <input type="checkbox"/> Welded <input type="checkbox"/> Surface 18 in. RMP <input checked="" type="checkbox"/> PVC <input type="checkbox"/> Weight 150 lbs./ft. Dia. 5 in. to 44 ft. depth Wall Thickness: inches or Dia. <input type="checkbox"/> in. to <input type="checkbox"/> ft. depth gage No. 200		
			10. Screen: Manufacturer's name J & J Type RMP Dia. 5 Slot/gauze .06 Length 20 Set between 20 ft. and 40 ft. ft. and <input type="checkbox"/> ft. Gravel pack? YES Size range of material 1/8		
Top soil Sandy clay Sand Fine Sand Fine to coarse Shale red			11. Static water level: <input type="checkbox"/> mo./day/yr. 15 ft. below land surface Date 8-26-76		
			12. Pumping level below land surfaces: 20 ft. after 1 hrs. pumping 25 g.p.m. <input type="checkbox"/> ft. after <input type="checkbox"/> hrs. pumping <input type="checkbox"/> g.p.m. Estimated maximum yield 25 g.p.m.		
			13. Water sample submitted: <input type="checkbox"/> mo./day/yr. Yes <input checked="" type="checkbox"/> No Date <input type="checkbox"/>		
			14. Well head completion: 18 <input type="checkbox"/> Pitless adapter 18 Inches above grade		
			15. Well grouted? YES With: <input checked="" type="checkbox"/> Neat cement <input type="checkbox"/> Bentonite <input type="checkbox"/> Concrete Depth: From 4 ft. to 14 ft.		
			16. Nearest source of possible contamination: SEPTIC ft. 100 Direction NW Type <input type="checkbox"/> Well disinfected upon completion? <input checked="" type="checkbox"/> Yes <input type="checkbox"/> No		
			17. Pump: <input checked="" type="checkbox"/> Not installed Manufacturer's name <input type="checkbox"/> Model number <input type="checkbox"/> HP <input type="checkbox"/> Volts <input type="checkbox"/> Length of drop pipe <input type="checkbox"/> ft. capacity <input type="checkbox"/> g.p.m. Type: <input type="checkbox"/> Submersible <input type="checkbox"/> Turbine <input type="checkbox"/> Jet <input type="checkbox"/> Reciprocating <input type="checkbox"/> Centrifugal <input type="checkbox"/> Other		
			(Use a second sheet if needed)		
18. Elevation: Topography: <input type="checkbox"/> Hill <input checked="" type="checkbox"/> Slope <input checked="" type="checkbox"/> Upland <input type="checkbox"/> Valley	19. Remarks: Mr Thiesen will run 4'x4' slab around well Allen J. Thiesen		20. Water well contractor's certification: This well was drilled under my jurisdiction and this report is true to the best of my knowledge and belief. DR Well Service 211 Business name License No. Address 428 W 3rd Newton KS Signed W. J. Williams Date 9-6-76 Authorized representative		

21-1-0-22 SYSTEM

Forward the white, blue and pink copies to the Department of Health and Environment

Form WWC-5