

WATER WELL RECORD


Form WWC-5

Division of Water Resources App. No.

1 LOCATION OF WATER WELL: County: Marion Fraction NW 1/4 SW 1/4 NW 1/4 Section Number 1 Township No. T 21 S Range Number R 1 NE W

Street/Rural Address of Well Location; if unknown, distance & direction from nearest town or intersection: If at owner's address, check here [X]. Global Positioning System (GPS) information: Latitude: Longitude: Elevation: Datum: [] WGS 84, [] NAD 83, [] NAD 27

2 WATER WELL OWNER: Patrick Flamming RR#, Street Address, Box #: 1265 Eagle Rd City, State, ZIP Code: Goessel Ks. 67053 Collection Method: [] GPS unit, [] Digital Map/Photo, [] Topographic Map, [] Land Survey

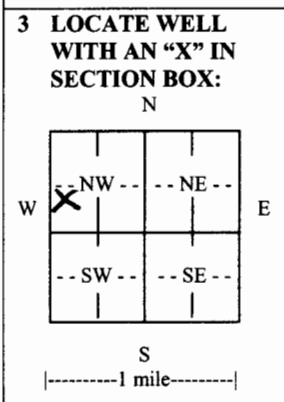

4 DEPTH OF COMPLETED WELL: 61 ft. Depth(s) Groundwater Encountered (1) 35 ft. (2) ft. (3) ft. WELL'S STATIC WATER LEVEL: 10 ft. below land surface measured on mo/day/yr. 8-16-10 Pump test data: Well water was ft. after hours pumping gpm EST. YIELD: 4-6 gpm Well water was ft. after hours pumping gpm Bore Hole Diameter: 2 in. to 20 ft., and ? in. to 61 ft. WELL WATER TO BE USED AS: [] Public water supply, [] Geothermal, [] Injection well, [] Domestic, [] Feedlot, [] Oil field water supply, [] Dewatering, [] Other (Specify below), [] Irrigation, [] Industrial, [X] Domestic-lawn & garden, [] Monitoring well

5 TYPE OF CASING USED: [] Steel, [X] PVC, [] Other CASING JOINTS: [X] Glued, [] Clamped, [] Welded, [] Threaded Casing diameter: 5 in. to 61 ft., Diameter in. to ft., Diameter in. to ft. Casing height above land surface: 12 in., Weight SDR 26 lbs./ft., Wall thickness or gauge No. 214

TYPE OF SCREEN OR PERFORATION MATERIAL: [] Steel, [] Stainless Steel, [X] PVC, [] Other (Specify) [] Brass, [] Galvanized Steel, [] None used (open hole) SCREEN OR PERFORATION OPENINGS ARE: [] Continuous slot, [] Mill slot, [] Gauze wrapped, [] Torch cut, [] Drilled holes, [] None (open hole), [] Louvered shutter, [] Key punched, [] Wire wrapped, [X] Saw cut, [] Other (specify) SCREEN-PERFORATED INTERVALS: From 30 ft. to 61 ft., From ft. to ft., From ft. to ft. GRAVEL PACK INTERVALS: From ft. to ft., From ft. to ft., From ft. to ft.

6 GROUT MATERIAL: [] Neat cement, [] Cement grout, [X] Bentonite, [] Other Grout Intervals: From 0 ft. to 20 ft., From ft. to ft., From ft. to ft. What is the nearest source of possible contamination: [] Septic tank, [] Lateral lines, [] Pit privy, [] Livestock pens, [] Insecticide storage, [] Other (specify below), [] Sewer lines, [] Cesspool, [X] Sewage lagoon, [] Fuel storage, [] Abandoned water well, [] Watertight sewer lines, [] Seepage pit, [] Feedyard, [] Fertilizer storage, [] Oil well/gas well Direction from well: S Distance from well: 100 +

Table with 6 columns: FROM, TO, LITHOLOGIC LOG, FROM, TO, LITHO. LOG (cont.) or PLUGGING INTERVALS. Rows contain: 0 to 6 Clay; 6 to 35 Shale; 35 to 36 Crumbled Shale & Water; 36 to 61 Gray Shale.

7 CONTRACTOR'S OR LANDOWNER'S CERTIFICATION: This water well was [X] constructed, [] reconstructed, or [] plugged under my jurisdiction and was completed on (mo/day/year) 8-16-10 and this record is true to the best of my knowledge and belief. Kansas Water Well Contractor's License No. 1000 This Water Well Record was completed on (mo/day/year) 8-23-10 under the business name of Backhaus Drilling by (signature) Paul H. Backhaus

INSTRUCTIONS: Use typewriter or ball point pen. PLEASE PRESS FIRMLY and PRINT clearly. Please fill in blanks and check the correct answers. Send three copies (white, blue, pink) to Kansas Department of Health and Environment, Bureau of Water, Geology Section, 1000 SW Jackson St., Suite 420, Topeka, Kansas 66612-1367. Telephone 785-296-5522. Send one copy to WATER WELL OWNER and retain one for your records. Include fee of \$5.00 for each constructed well. Visit us at http://www.kdheks.gov/waterwell/index.html.