

County: Marion Fraction: NW, SW, NE, SE Sec. 34 T. 21 S R. 1 E

**CORRECTION(S) to WATER WELL COMPLETION RECORD Form WWC-5 (to rectify lacking or incorrect information)**

Owner: John & Laura Goerzen

If location corrected, was listed as:

Location changed to:

Section-Township-Range: \_\_\_\_\_

\_\_\_\_\_

Fraction (1/4 calls): not reported

NW, SW, NE, SE

Other changes: Initial statements: 3-feet of brick casing removed. Casing height 3-feet below land surface.

Changed to: 5-feet of brick casing removed. Casing height 5-feet below land surface.

Comments: Plugging contractor referred to this well as N. well, located NW of the S. well. He removed 5-ft of casing and placed grout at and above where brick casing was removed.

Verification method: Spoke with John Unruh, West Branch Excavating, to confirm information. He did not fill out plugging record - well owner did. Google Earth & KDHE STR Finder used.


Initials: PKC Date: 10/29/2020

Submitted by:  Kansas Geological Survey, Data Resources Library, 1930 Constant Ave., Lawrence, KS 66047-3724

Kansas Dept. of Health & Environment, Bureau of Water, 1000 SW Jackson, Suite 420, Topeka, KS 66612-1367

**1 LOCATION OF WATER WELL:** Fraction  $\frac{1}{4}$   $\frac{1}{4}$   $\frac{1}{4}$   $\frac{1}{4}$  Section Number 34 Township Number T 21 S Range Number 1  E  W  
 County: Marion  
 Street/Rural Address of Well Location; if unknown, distance & direction from nearest town or intersection: If at owner's address, check here  733 Diamond Newton KS 67114  
**Global Positioning Systems (GPS) information:**  
 Latitude: ~~38.179390~~ 38.179390 (in decimal degrees)  
 Longitude: ~~-97.50582~~ -97.50582 (in decimal degrees)  
 Elevation: 1530  
 Horizontal Datum:  WGS84,  NAD83,  NAD27  
 Collection Method:

**2 WATER WELL OWNER:** John + Larry Goerzen  
 RR#, St. Address, Box #: 733 Diamond  
 City, State ZIP Code: Newton KS 67114  
 GPS unit (Make/Model): \_\_\_\_\_  
 Digital Map/Photo,  Topographic Map,  Land Survey  
 Est. Accuracy:  < 3 m,  3-5 m,  5-15 m,  > 15 m

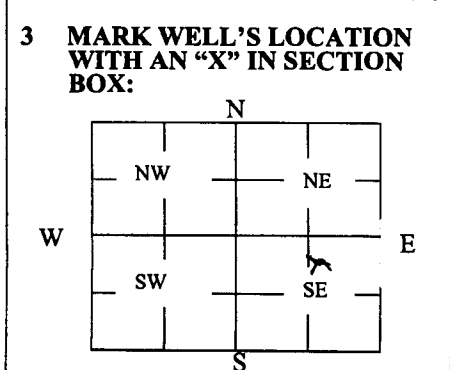

**4 DEPTH OF WELL** 16 ft.  
 WELL'S STATIC WATER LEVEL 5 ft.  
 WELL WAS USED AS:  
 Domestic  Public Water Supply  Dewatering  
 Irrigation  Oil Field Water Supply  Monitoring  
 Feedlot  Domestic (Lawn & Garden)  Injection Well  
 Industrial  Air Conditioning  Other \_\_\_\_\_  
 Was a chemical/bacteriological sample submitted to Department? Yes  No

**5 TYPE OF BLANK CASING USED:**  
 Steel  RMP (SR)  Wrought  Fiberglass  Other (Specify below)  
 PVC  ABS  Asbestos-Cement  Concrete Tile Brick  
 Blank casing diameter 5 ft in. Was casing pulled? Yes  No  If yes, how much 3 ft  
 Casing height above or below land surface 3 ft in.

**6 GROUT PLUG MATERIAL:**  Neat cement  Cement grout  Bentonite  Other \_\_\_\_\_  
 Grout Plug Intervals: From 4 ft. to 4.5 ft., From \_\_\_\_\_ ft. to \_\_\_\_\_ ft., From \_\_\_\_\_ ft. to \_\_\_\_\_ ft.  
 What is the nearest source of possible contamination:  
 Septic tank  Seepage pit  Fuel storage  Other (specify below)  
 Sewer lines  Pit privy  Fertilizer storage  
 Watertight sewer lines  Sewage lagoon  Insecticide storage  
 Lateral lines  Feedyard  Abandoned water well Direction from well? NW  
 Cess pool  Livestock pens  Oil well/Gas well How many feet? 112

FROM	TO	PLUGGING MATERIALS	FROM	TO	PLUGGING MATERIALS
<del>Surface</del>	4'	top soil			
4'	4.5'	bentonite			
4.5'	5'	subsoil			
5'	16'	sand / chlorine			

**7 CONTRACTOR'S OR LANDOWNER'S CERTIFICATION:** This water well was plugged under my jurisdiction and was completed on (mo/day/year) 8-4-2020 and this record is true to the best of my knowledge and belief. Kansas Water Well Contractor's License No. \_\_\_\_\_ This Water Well Record was completed on (mo/day/year) 8-4-2020 under the business name of West Branch Excavating LLC by (signature) [Signature]