


1 LOCATION OF WATER WELL: Fraction NW 1/4 NW 1/4 NW 1/4 Section Number 32 Township Number T 21 S Range Number R 10 EW
 County: ~~GREENWOOD~~ LYON

Distance and direction from nearest town or city street address of well if located within city?
 9 M-W OF OAPE - S.S.S

2 WATER WELL OWNER: CAROL RITCHIE REVOCABLE TRUST
 RR#, St. Address, Box #: 10 LYNWOOD Board of Agriculture, Division of Water Resource
 City, State, ZIP Code: WICHITA KS 67207 Application Number:

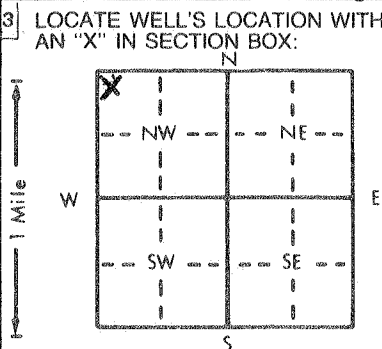

4 DEPTH OF COMPLETED WELL: 25 ft. ELEVATION:
 Depth(s) Groundwater Encountered 1. 8 ft. 2. - ft. 3. - ft.
 WELL'S STATIC WATER LEVEL: 7.7 ft. below land surface measured on mo/day/yr 06-23-95
 Pump test data: Well water was 8.6 ft. after 1 hours pumping 20 gpm
 Est. Yield: 28 gpm; Well water was 8.6 ft. after 2 hours pumping 20 gpm
 Bore Hole Diameter: 11.75 in. to 2.5 ft., and - in. to - ft.
 WELL WATER TO BE USED AS:
 1 Domestic 3 Feedlot 5 Public water supply 8 Air conditioning 11 Injection well
 2 Irrigation 4 Industrial 6 Oil field water supply 9 Dewatering 12 Other (Specify below)
 7 Lawn and garden only 10 Monitoring well
 Was a chemical/bacteriological sample submitted to Department? Yes - No X; If yes, mo/day/yr sample was submitted Water Well Disinfected? Yes X No -

5 TYPE OF BLANK CASING USED:
 1 Steel 3 RMP (SR) 5 Wrought iron 8 Concrete tile CASING JOINTS: Glued X Clamped -
 2 PVC 4 ABS 6 Asbestos-Cement 9 Other (specify below) Welded -
 7 Fiberglass Threaded -
 Blank casing diameter: 5 in. to 10 ft., Dia. - in. to - ft., Dia. - in. to - ft.
 Casing height above land surface: 39 in., weight SCH 40 lbs./ft. Wall thickness or gauge No. -
 TYPE OF SCREEN OR PERFORATION MATERIAL:
 1 Steel 3 Stainless steel 5 Fiberglass 7 PVC 10 Asbestos-cement
 2 Brass 4 Galvanized steel 6 Concrete tile 8 RMP (SR) 11 Other (specify) -
 12 None used (open hole)
 SCREEN OR PERFORATION OPENINGS ARE:
 1 Continuous slot 3 Mill slot 5 Gauzed wrapped 8 Saw cut 11 None (open hole)
 2 Louvered shutter 4 Key punched 6 Wire wrapped 9 Drilled holes
 7 Torch cut 10 Other (specify) -
 SCREEN-PERFORATED INTERVALS: From 10 ft. to 25 ft., From - ft. to - ft.
 GRAVEL PACK INTERVALS: From 9 ft. to 25 ft., From - ft. to - ft.

6 GROUT MATERIAL: 1 Neat cement 2 Cement grout 3 Bentonite 4 Other -
 Grout Intervals: From 1 ft. to 9 ft., From - ft. to - ft., From - ft. to - ft.
 What is the nearest source of possible contamination:
 1 Septic tank 4 Lateral lines 7 Pit privy 10 Livestock pens 14 Abandoned water well
 2 Sewer lines 5 Cess pool 8 Sewage lagoon 11 Fuel storage 15 Oil well/Gas well
 3 Watertight sewer lines 6 Seepage pit 9 Feedyard 12 Fertilizer storage 16 Other (specify below)
 GRAVEL PIT
 Direction from well? N How many feet? 75

FROM	TO	LITHOLOGIC LOG	FROM	TO	PLUGGING INTERVALS
0	8.5	SILT-LOAM BR - SCT-GRAVEL			
8.5	12	SAND-SILT-GRAVEL-L'S RUBBLE			
12	16	GRAVEL			
16	23	SHALE			
23	24.5	LIMB			
TD	25	SHALE			

7 CONTRACTOR'S OR LANDOWNER'S CERTIFICATION: This water well was (1) constructed, (2) reconstructed, or (3) plugged under my jurisdiction and was completed on (mo/day/year) 06-23-95 and this record is true to the best of my knowledge and belief. Kansas Water Well Contractor's License No. 429 This Water Well Record was completed on (mo/day/yr) 06-23-95 under the business name of EBBERTS DRILLING by (signature) Roger Ebbert