


1 LOCATION OF WATER WELL: County: **LYON** Fraction: **SW 1/4 NE 1/4 NW 1/4** Section Number: **2** Township Number: **T 21 S** Range Number: **R 11 EW**

Distance and direction from nearest town or city street address of well if located within city?  
**DLPE KS - FROM INTERSECTION OF HWY 99 AND CENTER ST - 1/8 S**

2 WATER WELL OWNER: **JOE MARKOWITZ** **BITTLERTOWN AD. BL. 4 - L 3-10**  
 RR#, St. Address, Box #: **BOX 214** Board of Agriculture, Division of Water Resources  
 City, State, ZIP Code: **DLPE KS 66865** Application Number:

3 LOCATE WELL'S LOCATION WITH AN "X" IN SECTION BOX:

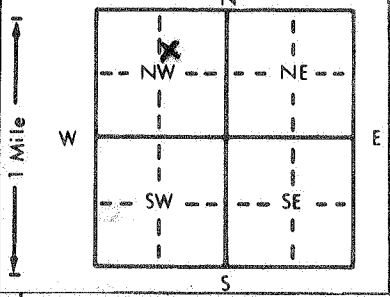

4 DEPTH OF COMPLETED WELL: **32** ft. ELEVATION: **---**  
 Depth(s) Groundwater Encountered: 1. **UN KN. D.W.M.** 2. **---** 3. **---**  
 WELL'S STATIC WATER LEVEL: **9** ft. below land surface measured on mo/day/yr **07-20-88**  
 Pump test data: Well water was **NO RECORD** hours pumping **---** gpm  
 Est. Yield: **---** gpm: Well water was **---** ft. after **---** hours pumping **---** gpm  
 Bore Hole Diameter: **APPROX. 6' - ROCK LINED AND RED. TO APPROX. 4'**  
 WELL WATER TO BE USED AS:  
 1 Domestic 3 Feedlot 6 Oil field water supply 9 Dewatering 12 Other (Specify below)  
 2 Irrigation 4 Industrial 7 Lawn and garden only 10 Monitoring well **---**  
 Was a chemical/bacteriological sample submitted to Department? Yes **---** No **X**; If yes, mo/day/yr sample was submitted  
 Water Well Disinfected? Yes **X** No

5 TYPE OF BLANK CASING USED:  
 1 Steel 3 RMP (SR) 5 Wrought iron 8 Concrete tile CASING JOINTS: Glued **X** Clamped **---**  
 2 PVC 4 ABS 6 Asbestos-Cement 9 Other (specify below) Welded **---**  
 7 Fiberglass Threaded **---**

Blank casing diameter: **5** in. to **32** ft. Dia. **---** in. to **---** ft. Dia. **---** in. to **---** ft.  
 Casing height above land surface: **20 \*** in., weight: **200** lbs./ft. Wall thickness or gauge No. **SC.H. 40**


TYPE OF SCREEN OR PERFORATION MATERIAL:  
 1 Steel 3 Stainless steel 5 Fiberglass 8 RMP (SR) 10 Asbestos-cement  
 2 Brass 4 Galvanized steel 6 Concrete tile 9 ABS 11 Other (specify) **---**  
 12 None used (open hole)

SCREEN OR PERFORATION OPENINGS ARE:  
 1 Continuous slot 3 Mill slot 5 Gauzed wrapped 8 Saw cut 11 None (open hole)  
 2 Louvered shutter 4 Key punched 6 Wire wrapped 9 Drilled holes  
 7 Torch cut 10 Other (specify) **---**

SCREEN-PERFORATED INTERVALS: From **25** ft. to **32** ft., From **---** ft. to **---** ft., From **---** ft. to **---** ft.  
 GRAVEL PACK INTERVALS: From **NA \*** ft. to **---** ft., From **---** ft. to **---** ft., From **---** ft. to **---** ft.

6 GROUT MATERIAL: 1 Neat cement 2 Cement grout 3 Bentonite 4 Other **NA \***  
 Grout Intervals: From **---** ft. to **---** ft., From **---** ft. to **---** ft., From **---** ft. to **---** ft.

What is the nearest source of possible contamination:  
 1 Septic tank 4 Lateral lines 7 Pit privy 10 Livestock pens 14 Abandoned water well  
 2 Sewer lines 5 Cess pool 8 Sewage lagoon 11 Fuel storage 15 Oil well/Gas well  
 3 Watertight sewer lines 6 Seepage pit 9 Feedyard 12 Fertilizer storage 16 Other (specify below)  
 13 Insecticide storage **NINE FOUND IN AREA**  
 Direction from well? **2-W 3-S** How many feet? **2-70 3-15**

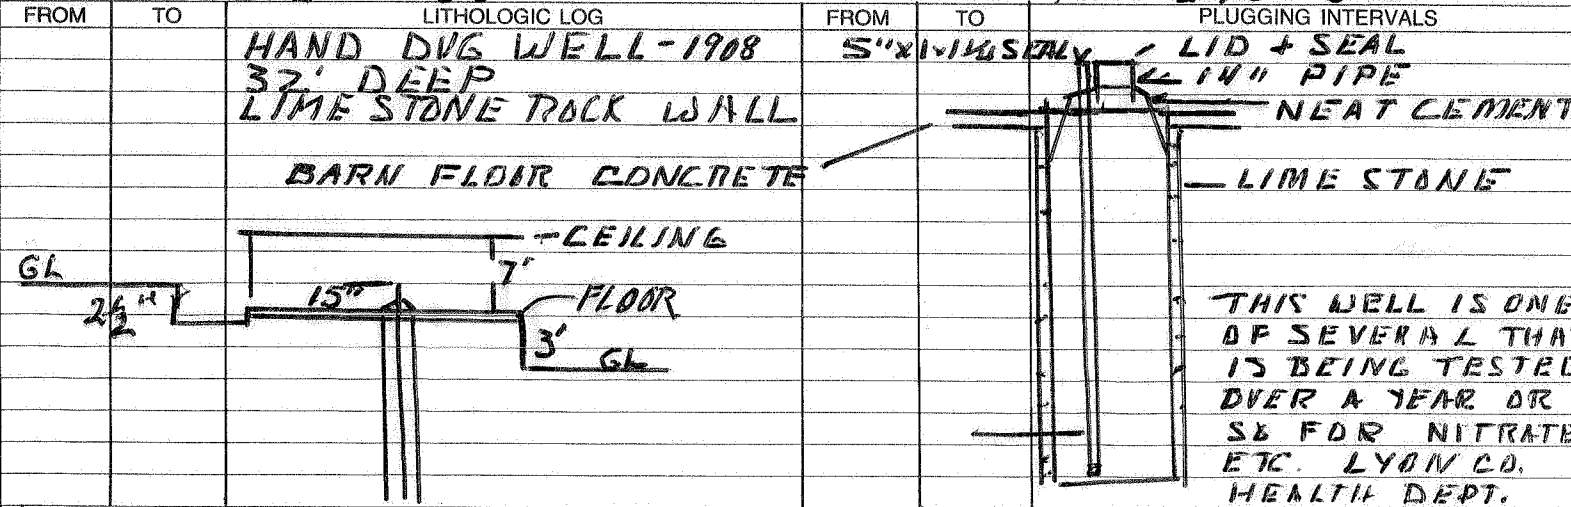

**THIS WELL IS ONE OF SEVERAL THAT IS BEING TESTED OVER A YEAR OR SO FOR NITRATE ETC. LYON CO. HEALTH DEPT.**

7 CONTRACTOR'S OR LANDOWNER'S CERTIFICATION: This water well was (1) constructed, (2) reconstructed, or (3) plugged under my jurisdiction and was completed on (mo/day/year) **07-26-88** and this record is true to the best of my knowledge and belief. Kansas Water Well Contractor's License No. **479** This Water Well Record was completed on (mo/day/yr) **07-29-88** under the business name of **EBBERTS DRILLING** by (signature) *Megan Ebberts*