


1 LOCATION OF WATER WELL: Fraction $\frac{1}{4}$ SW $\frac{1}{4}$ NW Section Number 2 Township Number T 21 S Range Number R 11 EW
 County: Lyon
 Distance and direction from nearest town or city street address of well if located within city?
 1/4 mile south of Texaco Station on Hwy 99 of Olpe

2 WATER WELL OWNER:
 RR#, St. Address, Box #: Rick Kehlmann Box 44 Olpe, Kansas 66865 Board of Agriculture, Division of Water Resources
 City, State, ZIP Code: Rick Kehlmann Box 44 Olpe, Kansas 66865 Application Number:

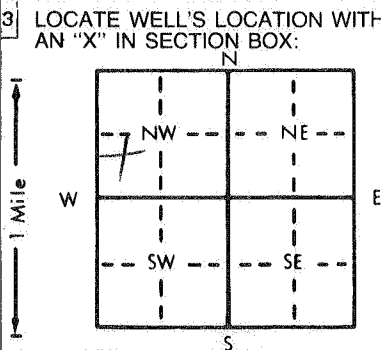

4 DEPTH OF COMPLETED WELL: 6 ft. ELEVATION:
 Depth(s) Groundwater Encountered 1. 1 1/2 ft. 2. ft. 3. ft.
 WELL'S STATIC WATER LEVEL: 4 1/2 ft. below land surface measured on mo/day/yr 6-27-89
 Pump test data: Well water was ft. after hours pumping gpm
 Est. Yield gpm: Well water was ft. after hours pumping gpm
 Bore Hole Diameter: in. to ft., and in. to ft.
 WELL WATER TO BE USED AS:
 1 Domestic 2 Irrigation 3 Feedlot 4 Industrial 5 Public water supply 6 Oil field water supply 7 Lawn and garden only 8 Air conditioning 9 Dewatering 10 Monitoring well 11 Injection well 12 Other (Specify below)
 12 Other (Specify below) Not Used for anything
 Was a chemical/bacteriological sample submitted to Department? Yes No; If yes, mo/day/yr sample was submitted
 Water Well Disinfected? Yes No

5 TYPE OF BLANK CASING USED:
 1 Steel 2 PVC 3 RMP (SR) 4 ABS 5 Wrought iron 6 Asbestos-Cement 7 Fiberglass 8 Concrete tile 9 Other (specify below) Rock CASING JOINTS: Glued Clamped Welded Threaded
 Blank casing diameter: 3 ft. in. to ft., Dia. in. to ft., Dia. in. to ft.
 Casing height above land surface: in., weight lbs./ft. Wall thickness or gauge No.
 TYPE OF SCREEN OR PERFORATION MATERIAL:
 1 Steel 2 Brass 3 Stainless steel 4 Galvanized steel 5 Fiberglass 6 Concrete tile 7 PVC 8 RMP (SR) 9 ABS 10 Asbestos-cement 11 Other (specify) 12 None used (open hole) NONE
 SCREEN OR PERFORATION OPENINGS ARE:
 1 Continuous slot 2 Louvered shutter 3 Mill slot 4 Key punched 5 Gauzed wrapped 6 Wire wrapped 7 Torch cut 8 Saw cut 9 Drilled holes 11 None (open hole) 10 Other (specify) NONE
 SCREEN-PERFORATED INTERVALS: From N/A ft. to ft., From ft. to ft., From ft. to ft., From ft. to ft.
 GRAVEL PACK INTERVALS: From ft. to ft., From ft. to ft., From ft. to ft., From ft. to ft.

6 GROUT MATERIAL: 1 Neat cement 2 Cement grout 3 Bentonite 4 Other Cement Plug
 Grout Intervals: From 0 ft. to 3 ft., From ft. to ft., From ft. to ft., From ft. to ft.
 What is the nearest source of possible contamination:
 1 Septic tank 2 Sewer lines 3 Watertight sewer lines 4 Lateral lines 5 Cess pool 6 Seepage pit 7 Pit privy 8 Sewage lagoon 9 Feedyard 10 Livestock pens 11 Fuel storage 12 Fertilizer storage 13 Insecticide storage 14 Abandoned water well 15 Oil well/Gas well 16 Other (specify below)
 Direction from well? SOUTH How many feet? 250

FROM	TO	LITHOLOGIC LOG	FROM	TO	PLUGGING INTERVALS
		Lagoon 250 to 300 yards to the South			The well was an old well that has not been used for several years. It was fill in from natural causes up to 6' from the top. The slides were then pushed in after 1 gal. bleach was poured into the water (1' of water) to disinfect the water. Then gravel was added to the well. Then approx 1/2' of dirt was added with a cement top on the dirt. After the cement the well was filled in with dirt.
6	5	Sand			
5	4	Dirt			
4	3	Cement plug			
3	0	Clay			

7 CONTRACTOR'S OR LANDOWNER'S CERTIFICATION: This water well was (1) constructed, (2) reconstructed, or (3) plugged under my jurisdiction and was completed on (mo/day/year) 6-27-89 and this record is true to the best of my knowledge and belief. Kansas Water Well Contractor's License No. This Water Well Record was completed on (mo/day/yr) under the business name of by (signature)

INSTRUCTIONS: Use typewriter or ball point pen. PLEASE PRESS FIRMLY and PRINT clearly. Please fill in blanks, underline or circle the correct answers. Send top three copies to Kansas Department of Health and Environment, Bureau of Water Protection, Topeka, Kansas 66620-7320. Telephone: 913-296-5514. Send one to WATER WELL OWNER and retain one for your records.

Disinfect with 1 gal BLEACH